


T. 8 S. R. 39 E. W. M.

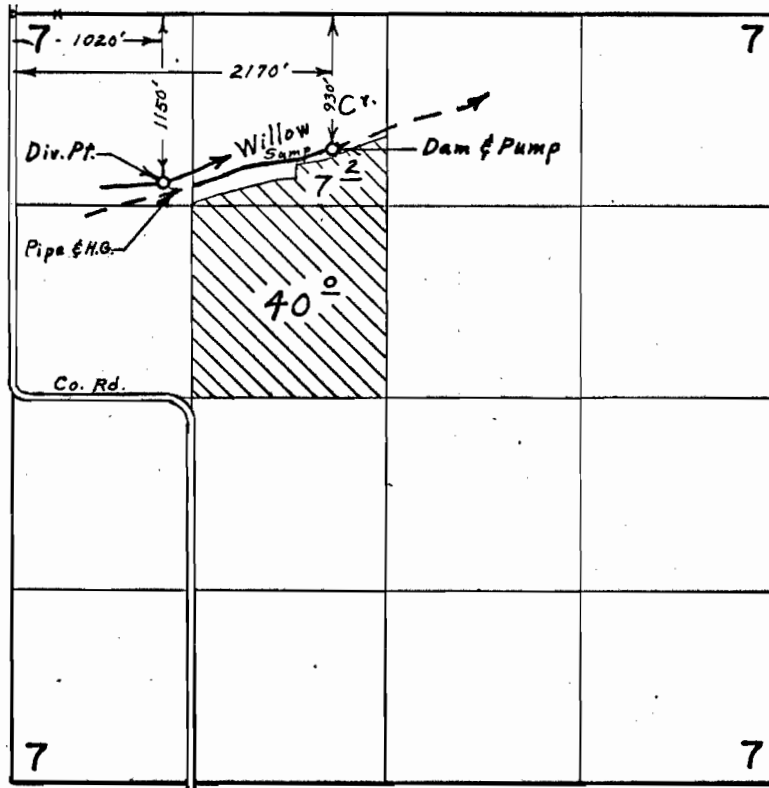

FINAL PROOF SURVEY UNDER

Application No. 41738 G-3131 Permit No. 31160 G-2929
IN NAME OF

FAYE P. LILLARD

Surveyed July 6, 1970, by L. E. Gould