


T. 8S., R. 38E., W.M.

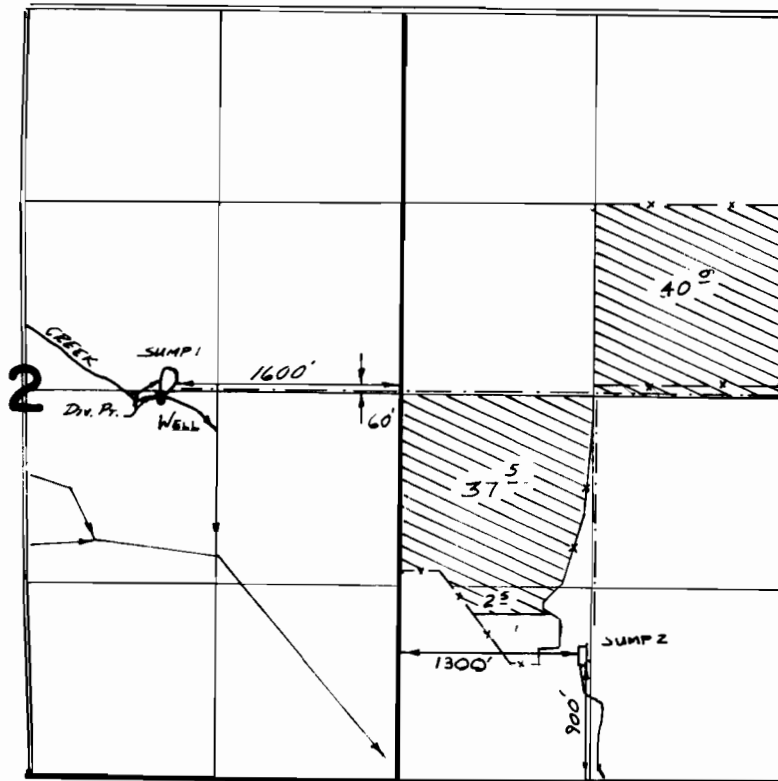

WELL LOCATED 60'S & 950'E. FROM CENTER SEC 2

FINAL PROOF SURVEY
UNDER

G-8613 G-7981
G-8612 G-7980
Application No. G-8287 Permit No. G-7979

IN NAME OF

.....TIM.....L.....KERNS.....

Surveyed 10-30..... 1978., by R. BAERLIN.....

2792
PTS-1978-P-E

8-15-83 V.L.C.
RE-4-29-83 V.L.C.
V.L.C.