


T.6S. R.39E. W.M.

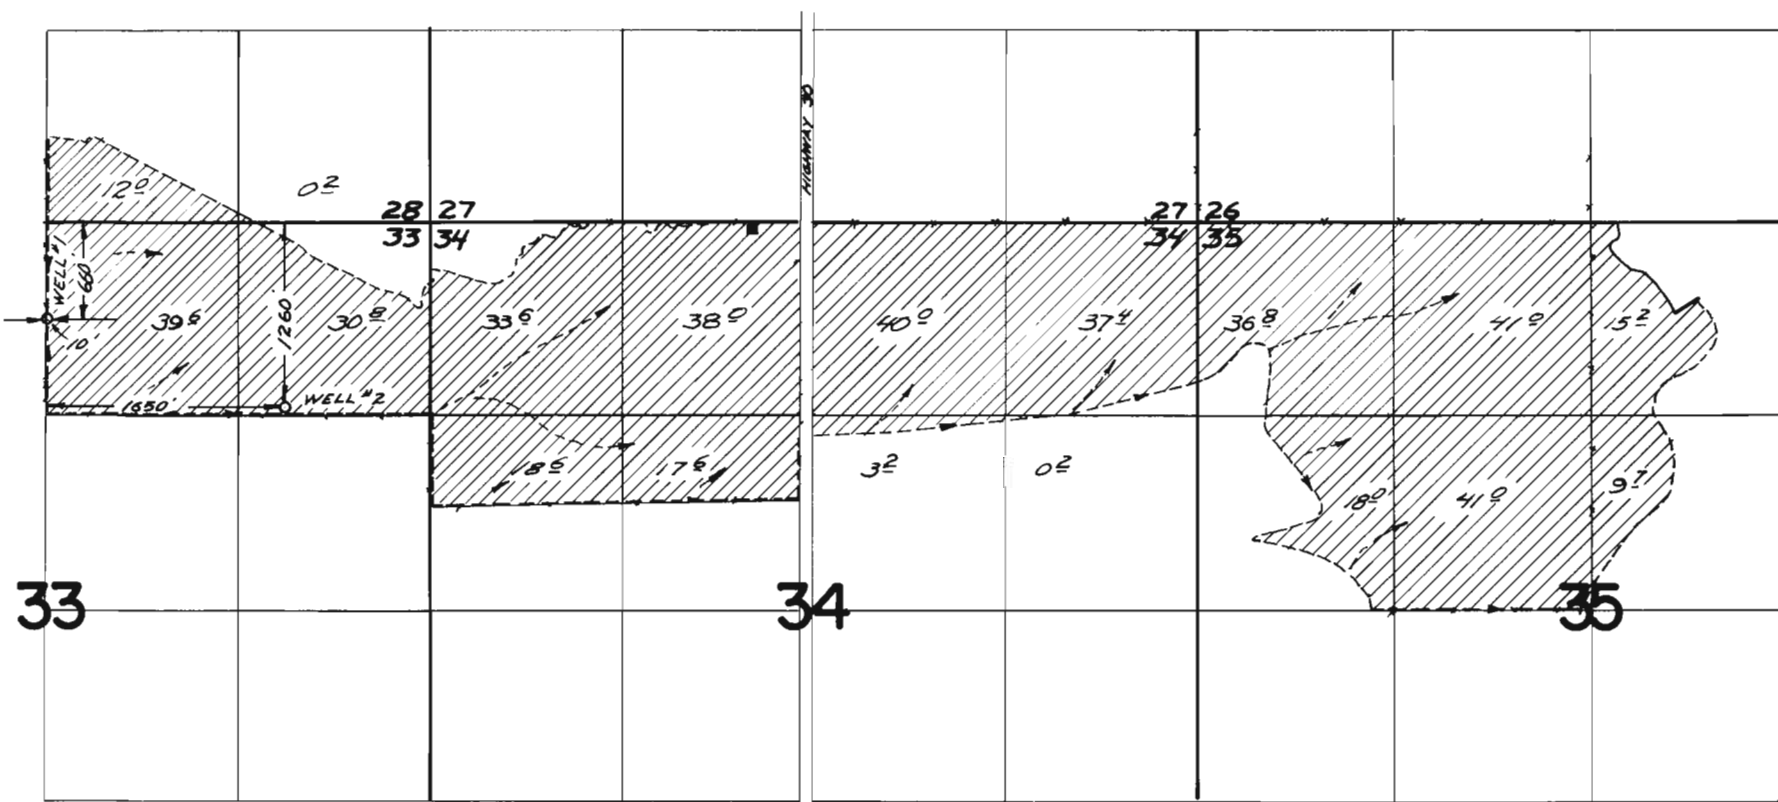

FINAL PROOF SURVEY

UNDER

Application No. G 2861 Permit No. G 2662

IN NAME OF

R. D. RASMUSSEN

Surveyed October 31, 1967 by V. R. Garner