



T. 6 S., R. 39E., W. M.

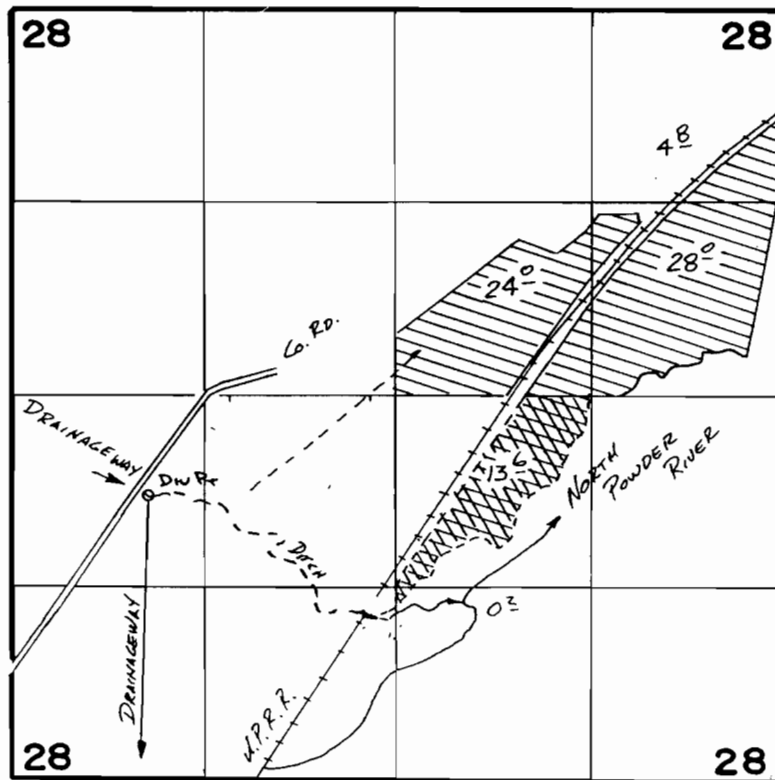

Div Pt Loc: 1930' N & 760' E FROM SW CORNER SECTION 28

SCALE: 1" = 1320'

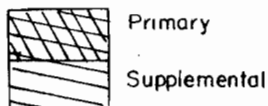

FINAL PROOF SURVEY
UNDER

Application No. **68458** Permit No. **49603**
IN NAME OF

ESTATE OF WILLIAMS, J. C.

Surveyed 11-22, 1982, by *V. L. Church*