


T.24S.R.7W.W.M.

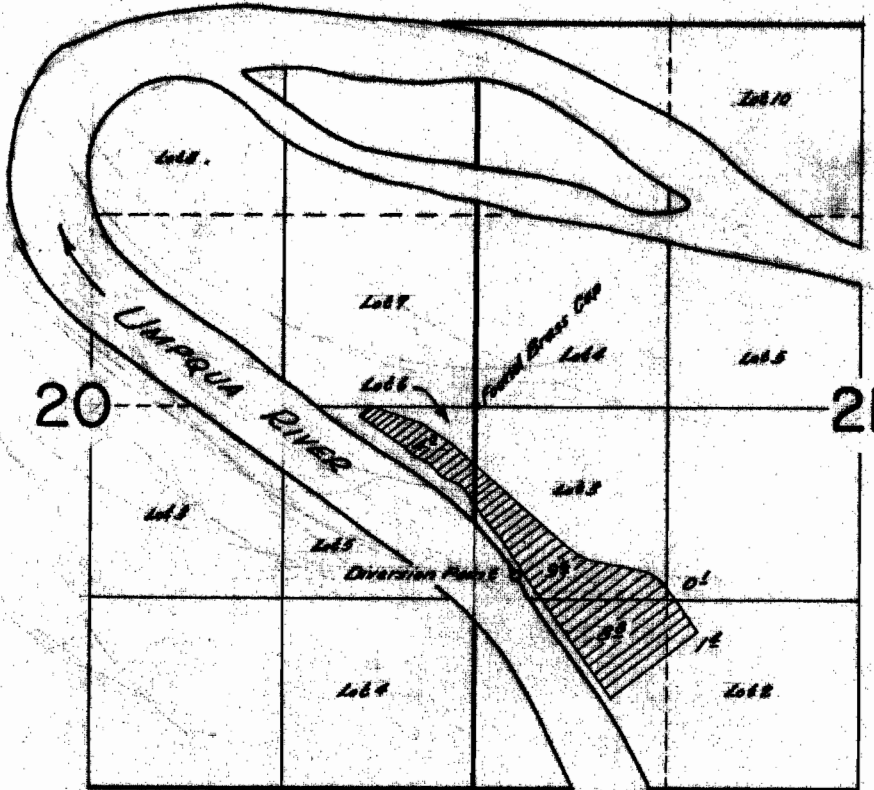

**FINAL PROOF SURVEY
UNDER**

Application No. 37634, Permit No. 28061....
IN NAME OF

Adolph Olson

Surveyed June 6, 1963, by T. Lauer