

R 9522

74116

Form OR-010-7300-2
4/83

UNITED STATES
DEPARTMENT OF THE INTERIOR
BUREAU OF LAND MANAGEMENT

Section

18

SW SW

Township 32 south
Range 22 east


Appl. No.

R67666

Permit No.

R 9522

Kelso Reservoir (#1513)

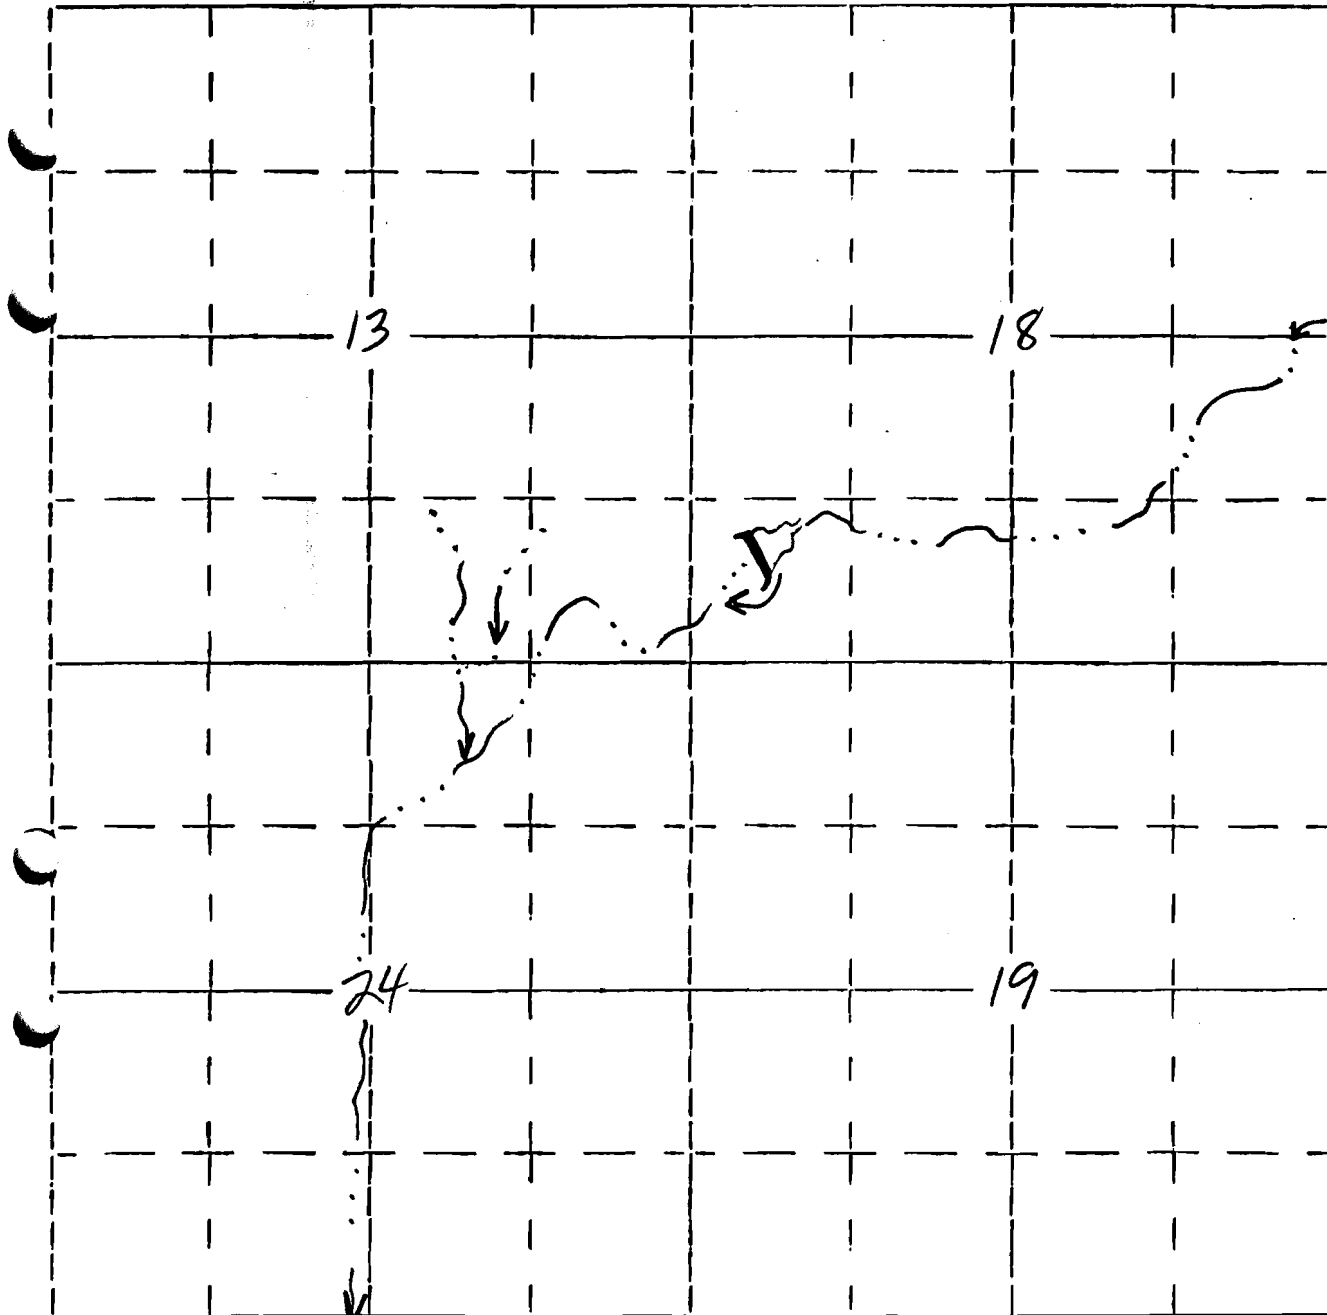

845' N., 580' E. of SW corner of section 18

R 21 E

R 22 E