

R-9526
7417

Form OR-010-7300-2
4/83


UNITED STATES
DEPARTMENT OF THE INTERIOR
BUREAU OF LAND MANAGEMENT

Section 18
NW NW

Township 29 south
Range 15 east

Appl. No. R67670
Permit No. R 9526

Bunchgrass Butte Reservoir (#4986)

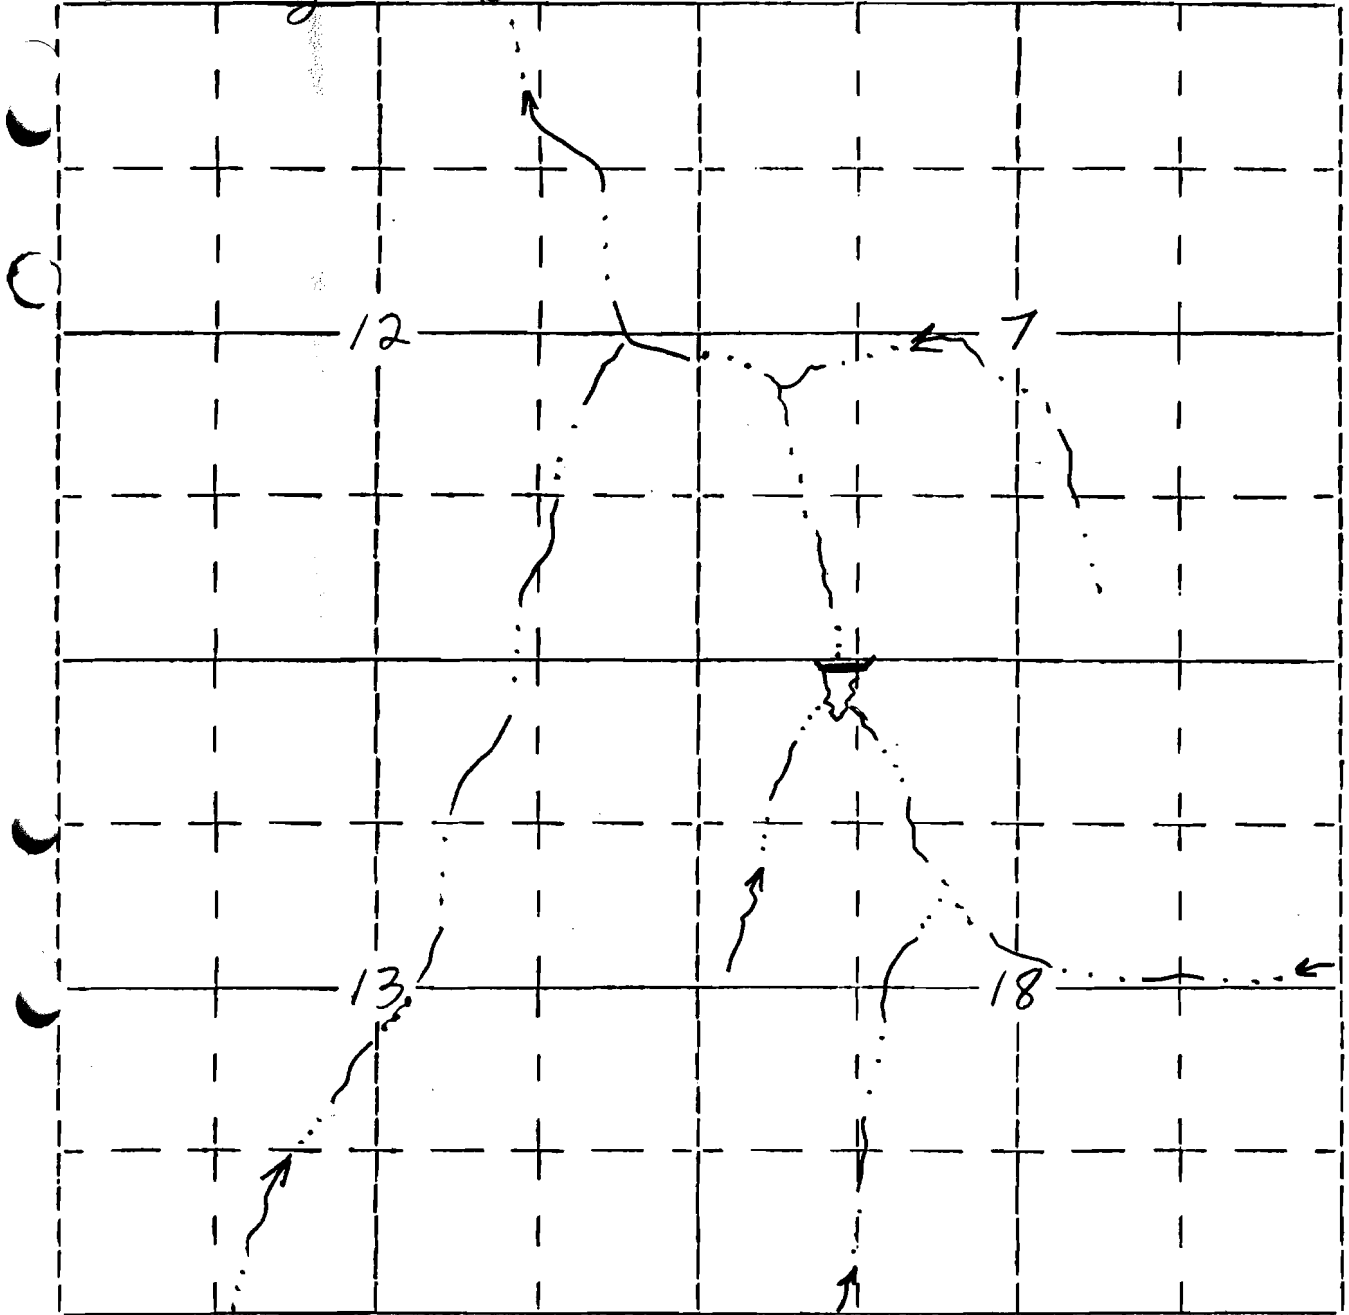

1280' E., 50' S. of NW corner, section 18

R 14 E

R 15 E