

R-9587
74118

Form OR-010-7300-2
4/83

UNITED STATES
DEPARTMENT OF THE INTERIOR
BUREAU OF LAND MANAGEMENT


Section 14
NE NW

Township 29 south
Range 15 east

Appl. No. R-67779

Permit No. R 9587

Rim Waterhole #2 (#5311)

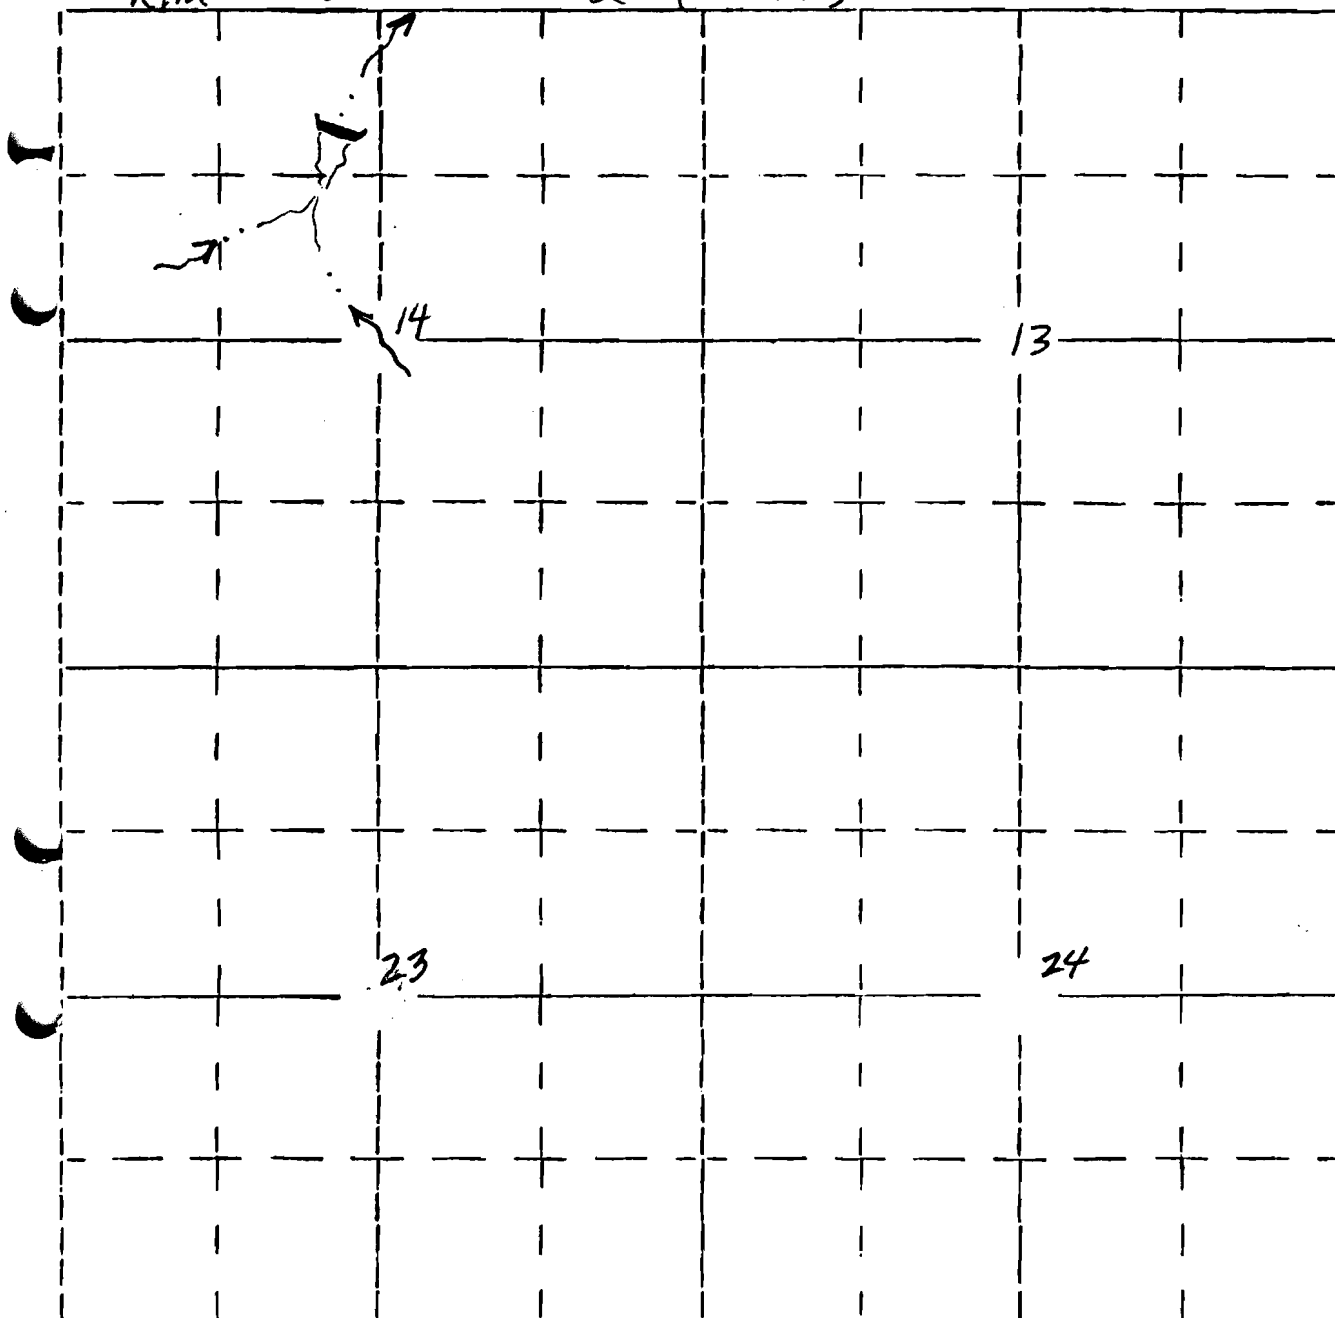

1105' S., 2440' E. of NW corner, section 14