

R9591
74120

Form OR-010-7300-2
4/83

UNITED STATES
DEPARTMENT OF THE INTERIOR
BUREAU OF LAND MANAGEMENT

Section

21


NWSE

Township 29 south
Range 15 east

Appl. No. R-67783

Permit No. R 9591

Murphy Reservoir #1 (5312)

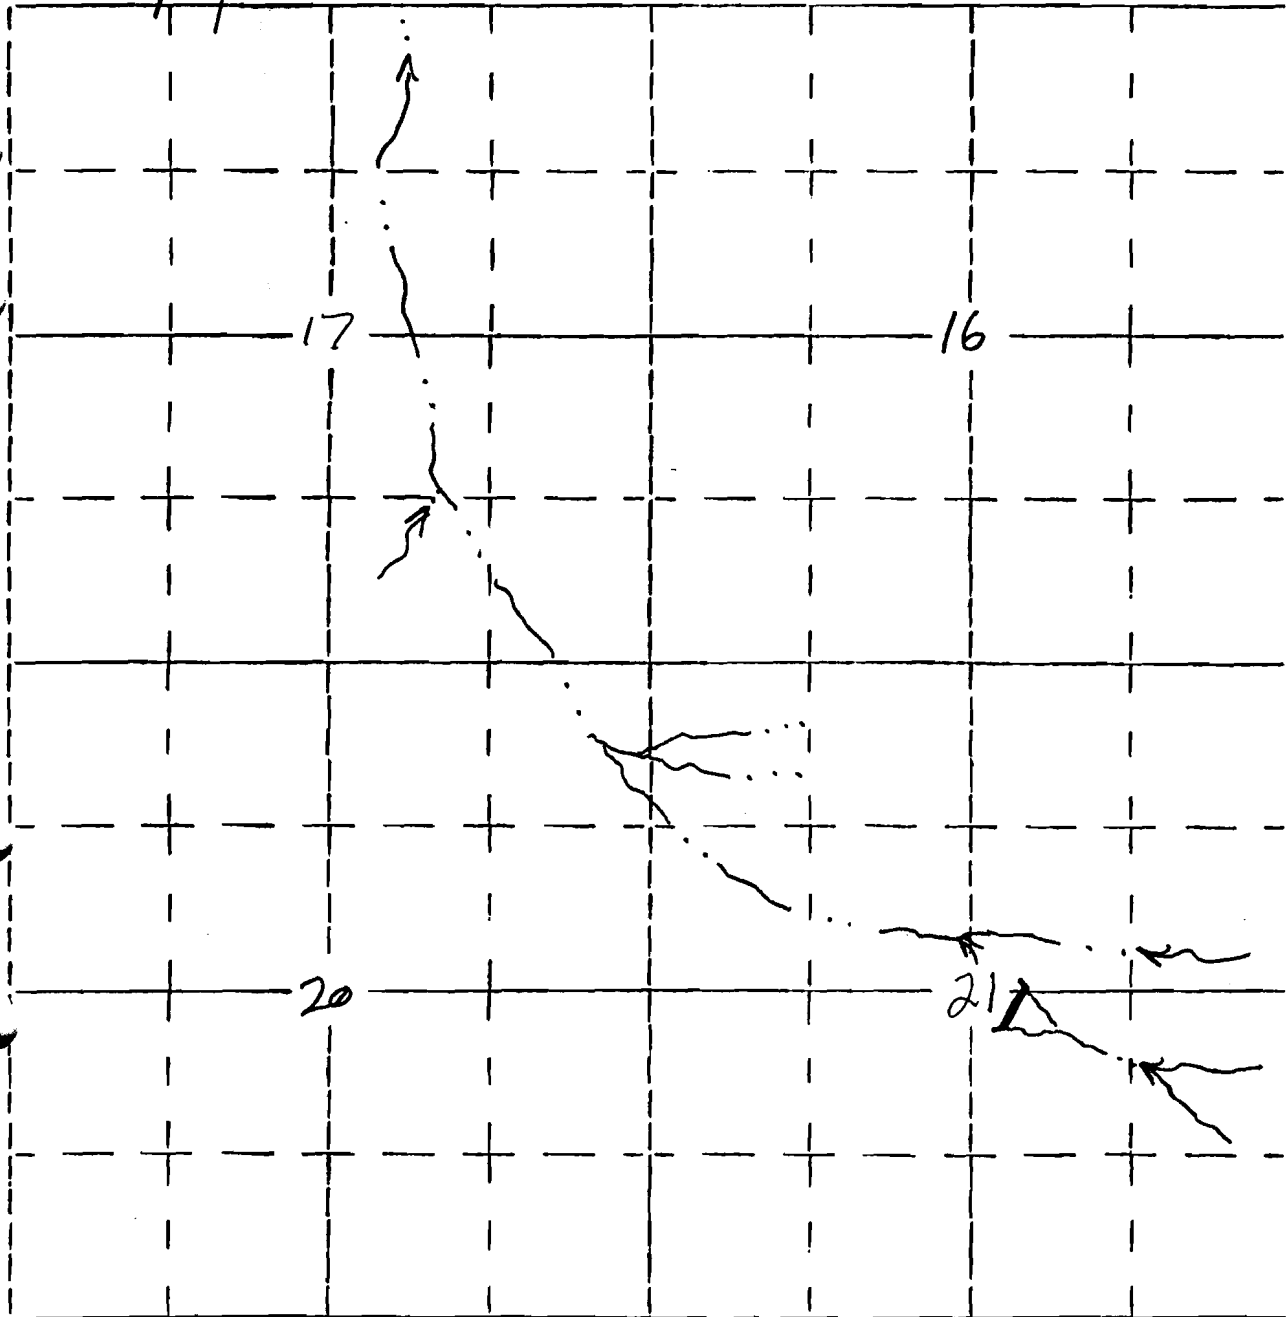

2600' N., 2420' W, of SE Conner, section 21

RECEIVED

OCT 14 1983
WATER RESOURCES DEPT.
SALEM, OREGON