

R9593
74121

Form OR-010-7300-2
4/83


UNITED STATES
DEPARTMENT OF THE INTERIOR
BUREAU OF LAND MANAGEMENT

Section
22
NW SE

Township 27 south
Range 13 east

Appl. No. R-67785
Permit No. R 9593

North Ward Res. (#5265)

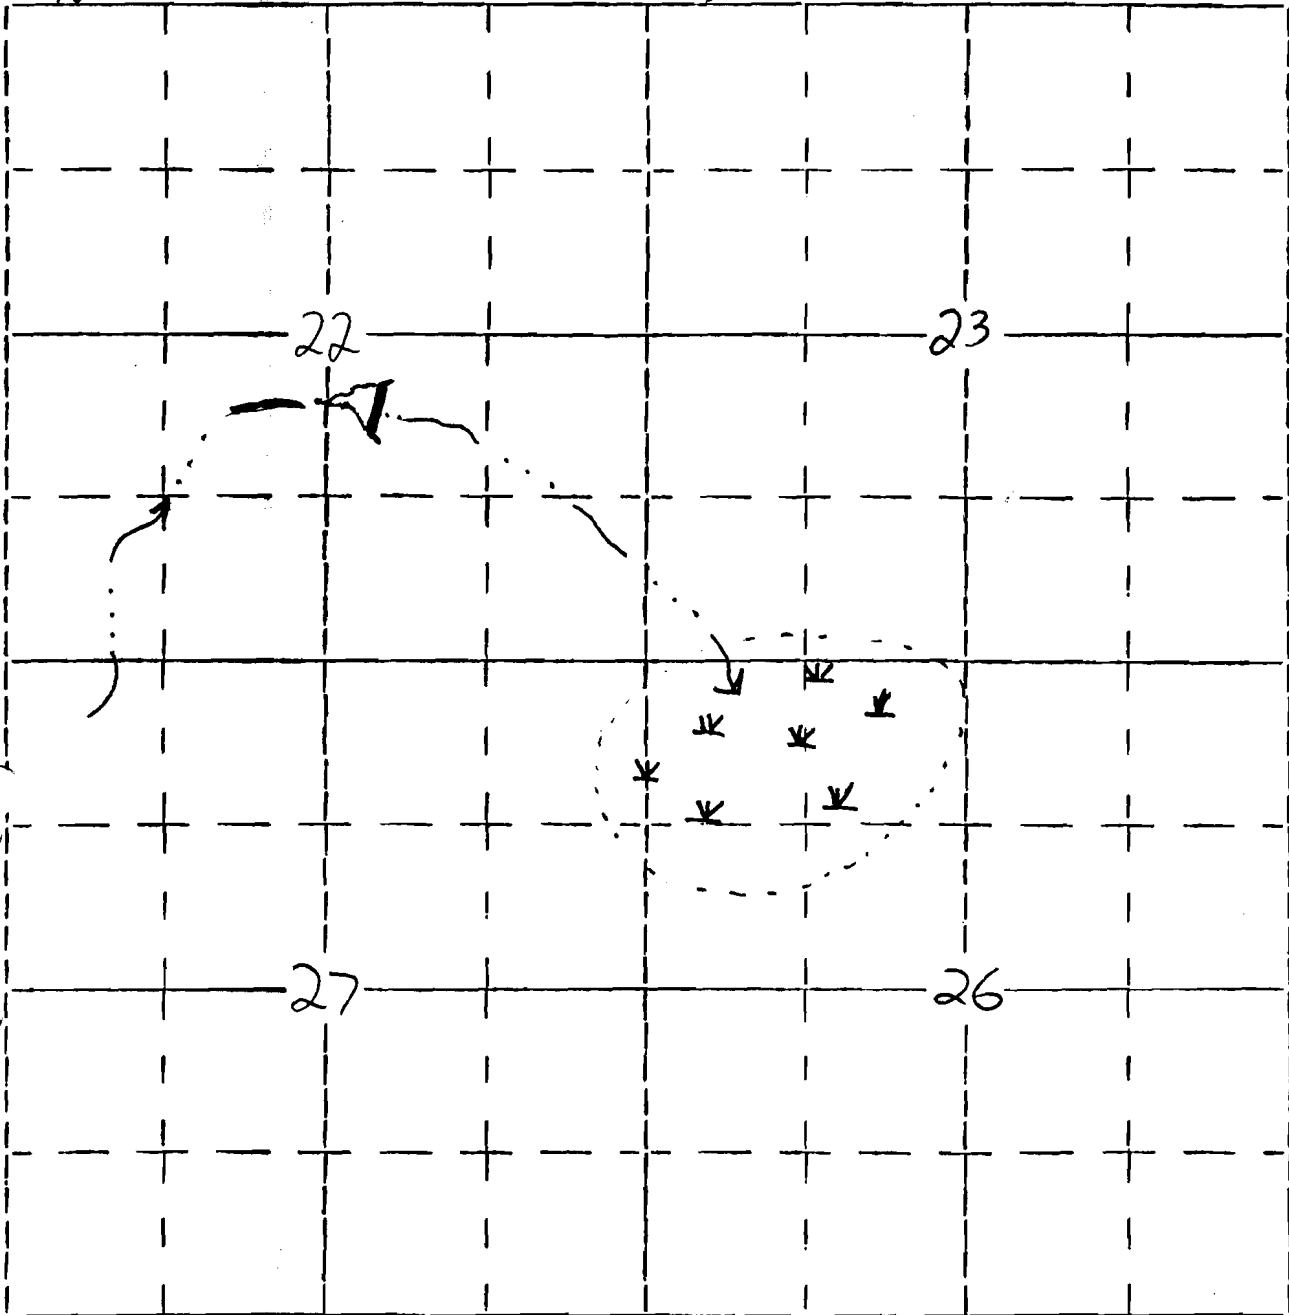

2005' N., -2440' W. of SE Corner, section 22

RECEIVED

OCT 1 1983
WATER RESOURCES DEPT.
SALEM, OREGON