


FINAL PROOF MAP


SECTIONS 21 & 28 T.36S. R.29E. WM.
 HARNEY COUNTY, OREGON
 APPLICATION NO 69268
 PERMIT NO 50752

GILLET MC RANX
 (MC GROUP)

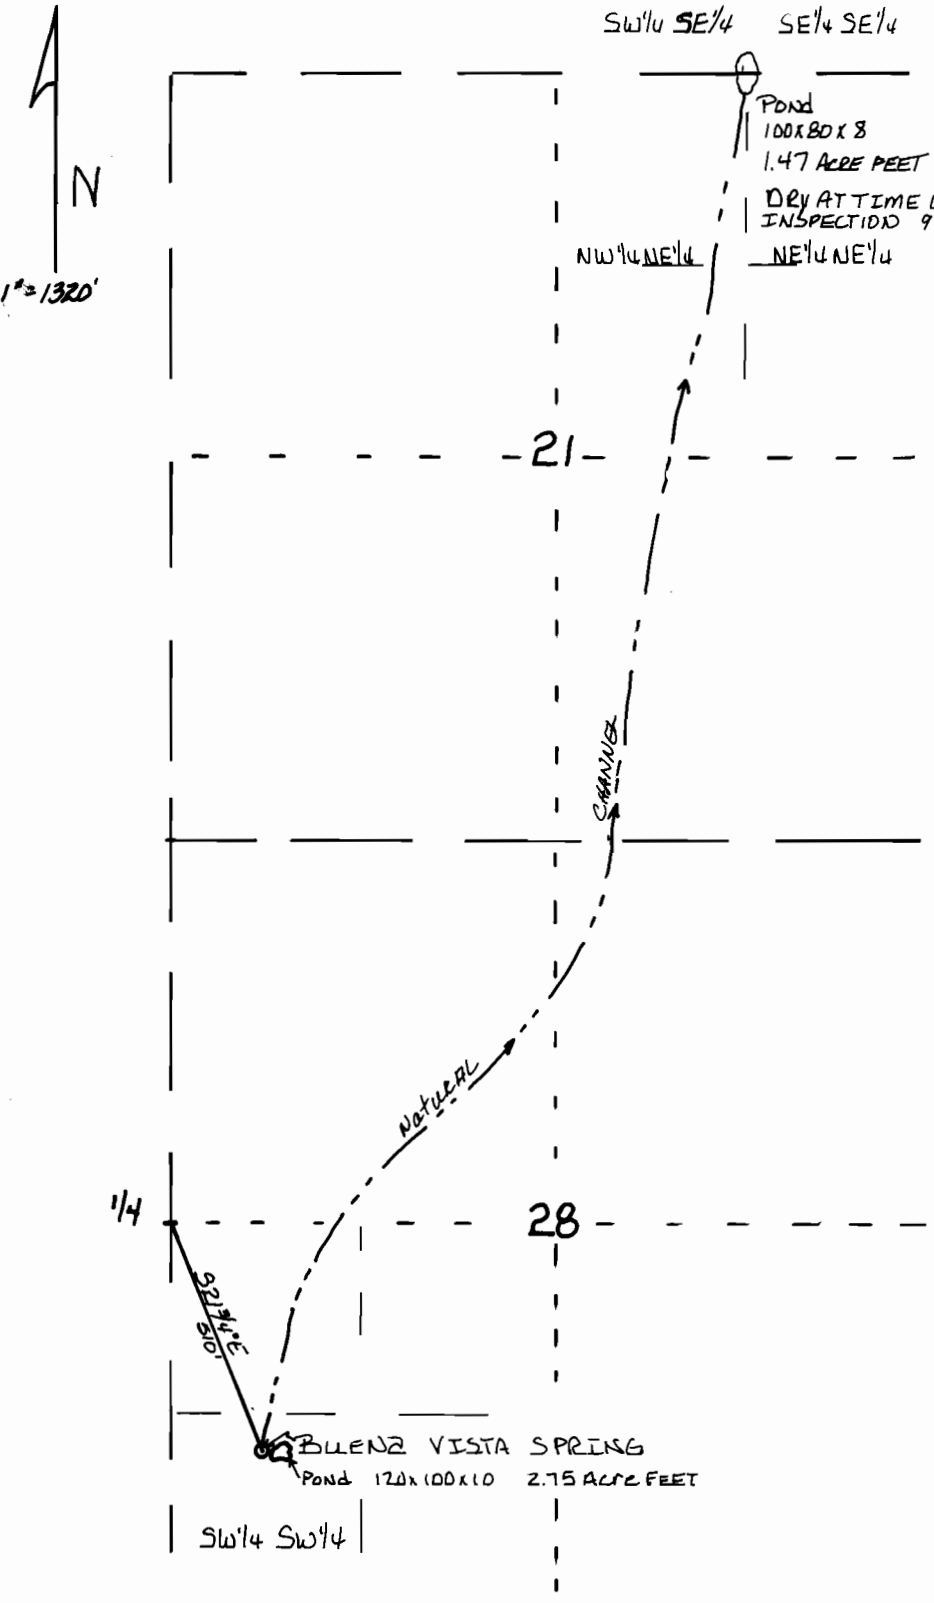

This map is for the purpose of identifying the location of the water right only and is not intended to provide legal dimensions or location of property ownership lines.

DE# WR 5393 9-29-93

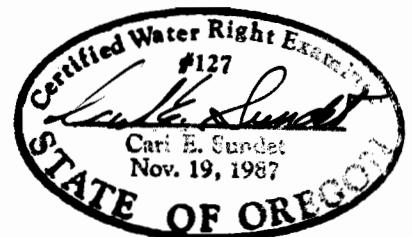

EXPIRES 12/31/94