
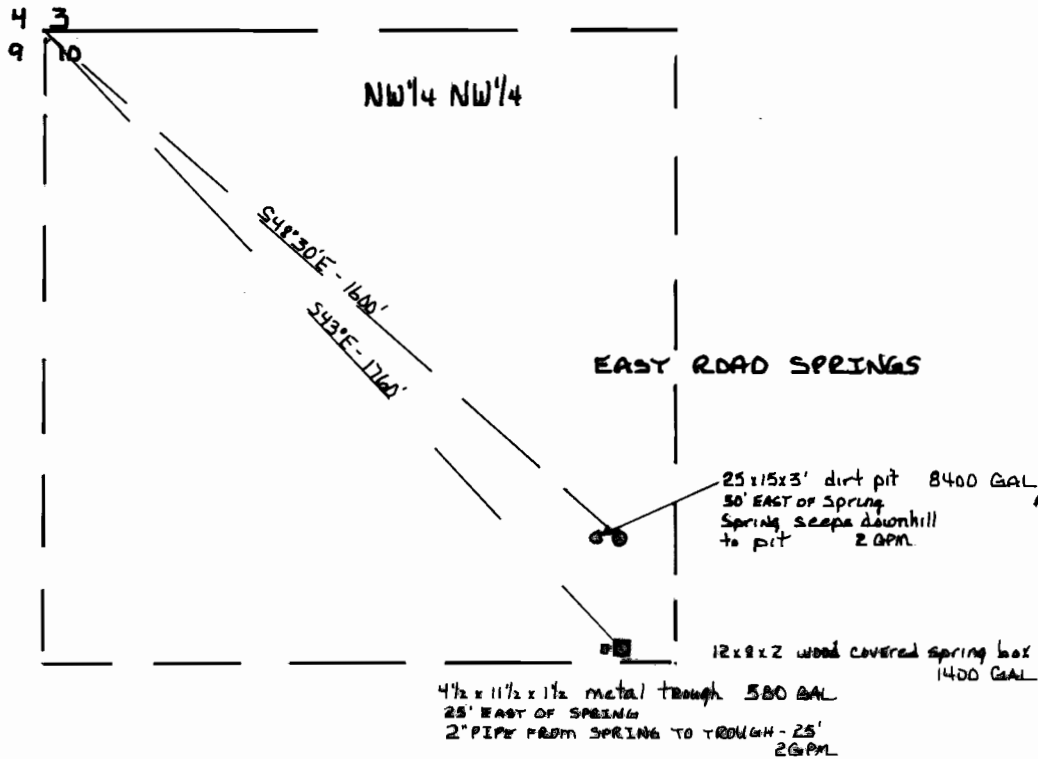


FINAL PROOF MAP

SECTION 10 T37S R29EWM
HARNEY COUNTY, OREGON
APPLICATION NO 69274
PERMIT NO 50757

GILLET MC RANCH
(LMC GROUP)

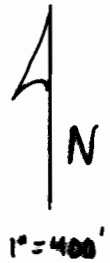

Site visit 9-27&28-1993.
Spring ties are scaled from USGS map
There are no corners in this area


This map is for the purpose of identifying the Location
of the water right only and is not intended to provide
legal dimensions or location of property ownership lines

De*WE 5094 9.29.93

RECEIVED

1993

WATER RESOURCES DEPT.
HARNEY COUNTY, OREGON

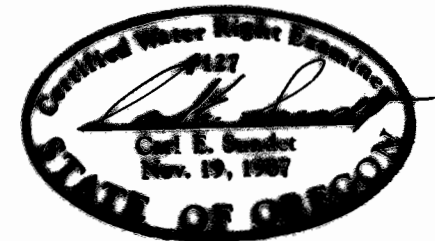

EXPIRES 12-31-94