


T.1500

FINAL PROOF SURVEY
SURVEYED: SEPT. 22, 1993
APPLICATIONS R-70040, 70041 PERMITS R-11192, 50837

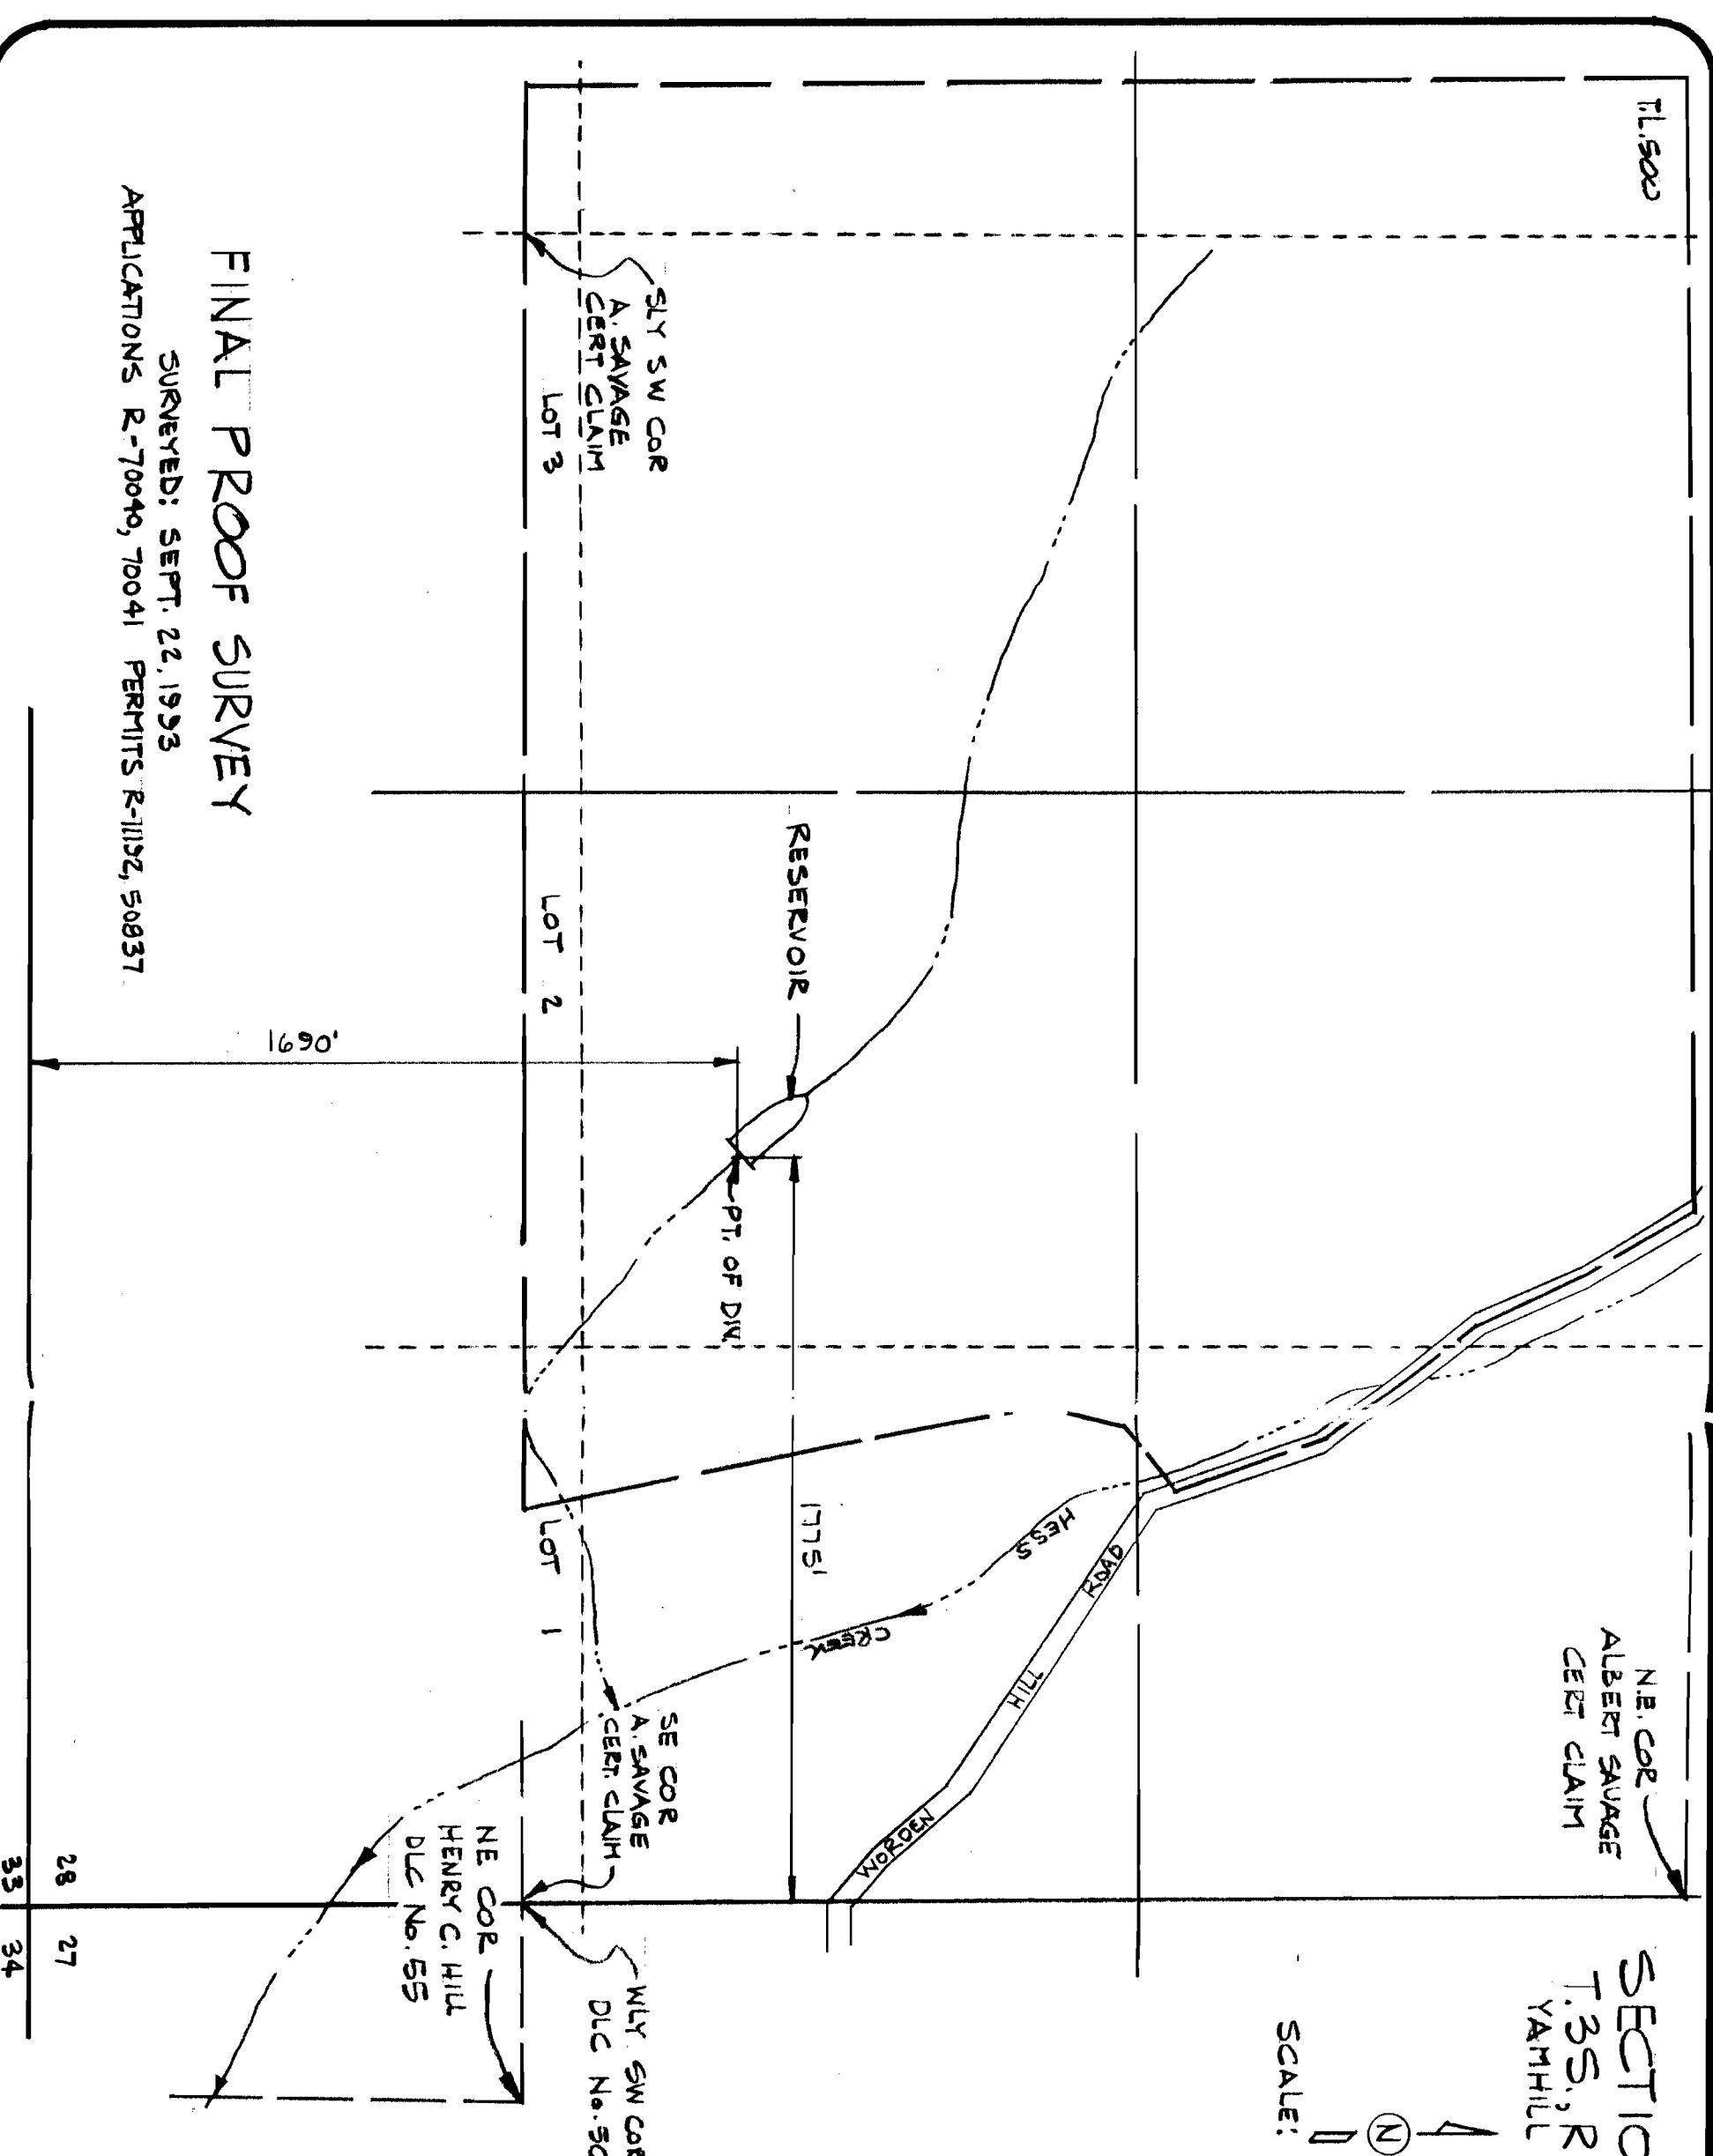

N.E. COR
ALBERT SAVAGE
CERT CLAIM

SECTION 28
T.35S, R.3W, W.1M
YAMHILL COUNTY

SCALE: 1 1/2" = 400'
N

S.W. COR
A. SAVAGE
CERT CLAIM
LOT 3

LOT 2

LOT 1

S.E. COR
A. SAVAGE
CERT CLAIM

N.E. COR
HENRY C. HILL
DLC No. 55

N.W. COR
DLC No. 56

RESERVOIR

PT. OF DIV.

1775'

CREEK

HILL

ROAD

W. COR



PREPARATION OF THIS MAP IS FOR THE PURPOSE OF IDENTIFYING THE LOCATION OF THE WATER RIGHT ONLY. THERE IS NO INTENT TO PROVIDE DIMENSIONS OR LOCATION OF PROPERTY OWNERSHIP LINES.

VERBOORT ENGINEERING
AGRICULTURE • CIVIL • WATER RESOURCES
HILLSBORO, OREGON

	by	date
designed	WRV	9-22-93
drawn	JER	9-22-93
checked	WRV	9-22-93
drawing no.	93-B-21	
sheet no.	1/1	

KNUDSEN VINEYARDS
1700 NE. KNUDSEN LANE
DUNDEE, OR 97115