

T. 28 S. R. 14 W.W.M.**RECEIVED****RECEIVED**

DEC 16 1992

SECTION 3

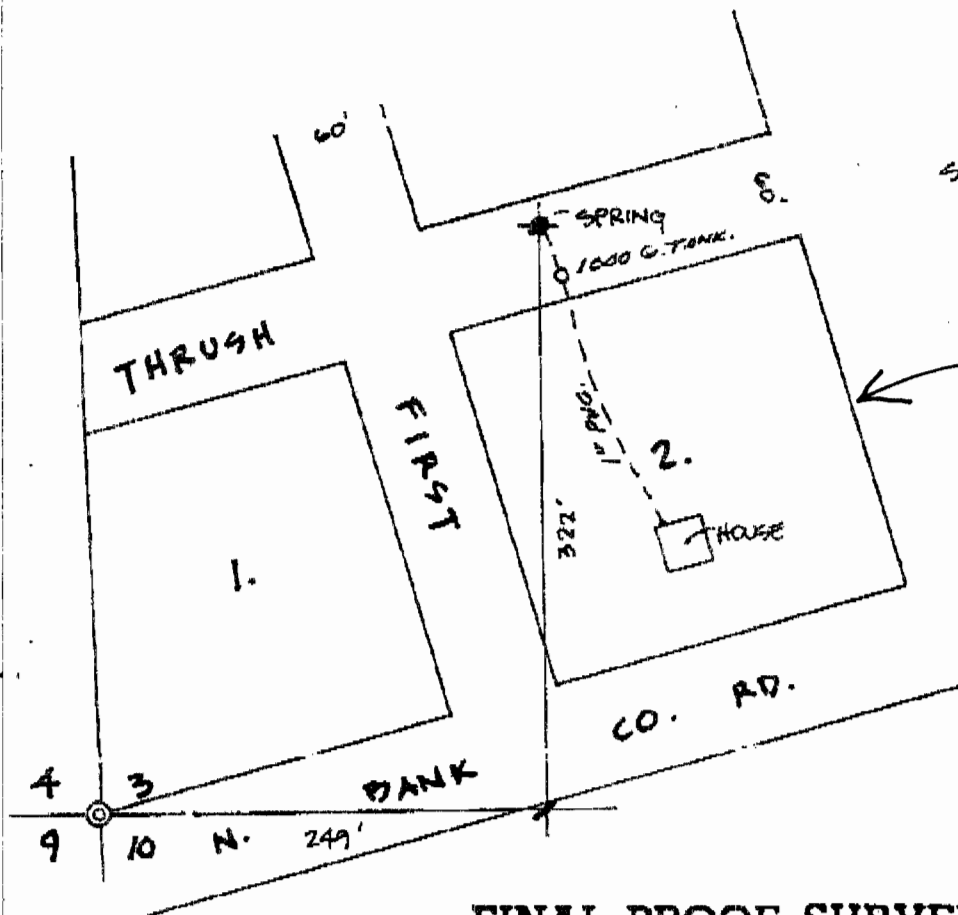
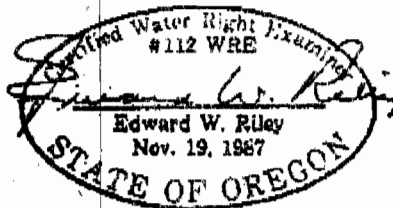
AUG 04 2000

WATER RESOURCES DEPT.
SALEM, OREGON**(SW 1/4 SW 1/4)**WATER RESOURCES DEPT.
SALEM, OREGON

THIS MAP IS FOR THE PURPOSE OF LOCATING THE WATER RIGHT ONLY AND IS NOT INTENDED TO PROVIDE LEGAL DIMENSIONS OR LOCATIONS OF PROPERTY OWNERSHIP LINES



SCALE = 1" = 100'

**FINAL PROOF SURVEY**
UNDERApplication No. 71594 Permit No. 51435
IN NAME OFDonald R. & Helen M. JongsSurveyed 5-16, 1992 by M. Dado