


T.23 S., R.7 W., W.M.
SECTION 28

SCALE: 1" = 1320'

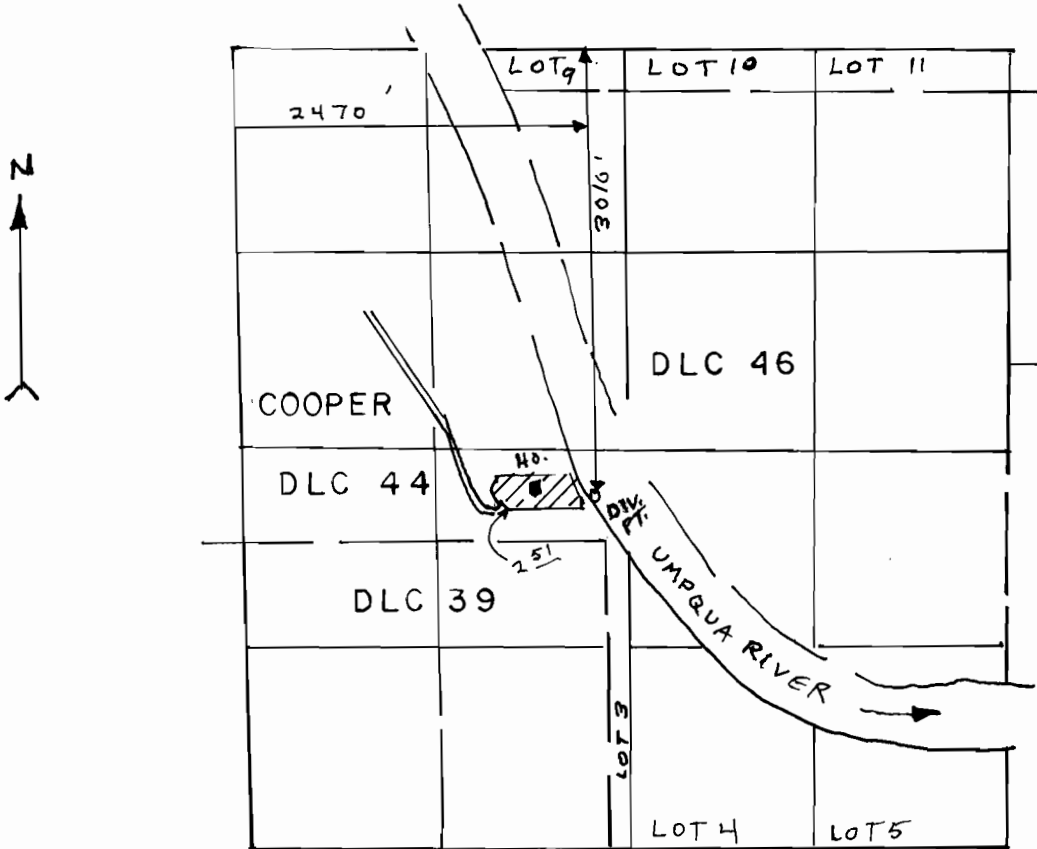

THE PURPOSE OF THIS MAP IS TO IDENTIFY THE LOCATION OF THE WATER RIGHT. IT IS NOT INTENDED TO PROVIDE INFORMATION RELATIVE TO THE LOCATION OF PROPERTY OWNERSHIP BOUNDARY LINES.

FINAL PROOF SURVEY
UNDER



Application No. 71384 Permit No. 51227

IN NAME OF

WARREN STEELE
JEWEL STEELE

Surveyed MAY. 1 1993, by DUANE KIRBY