


T. 27 S., R. 12 W., SEC. 24

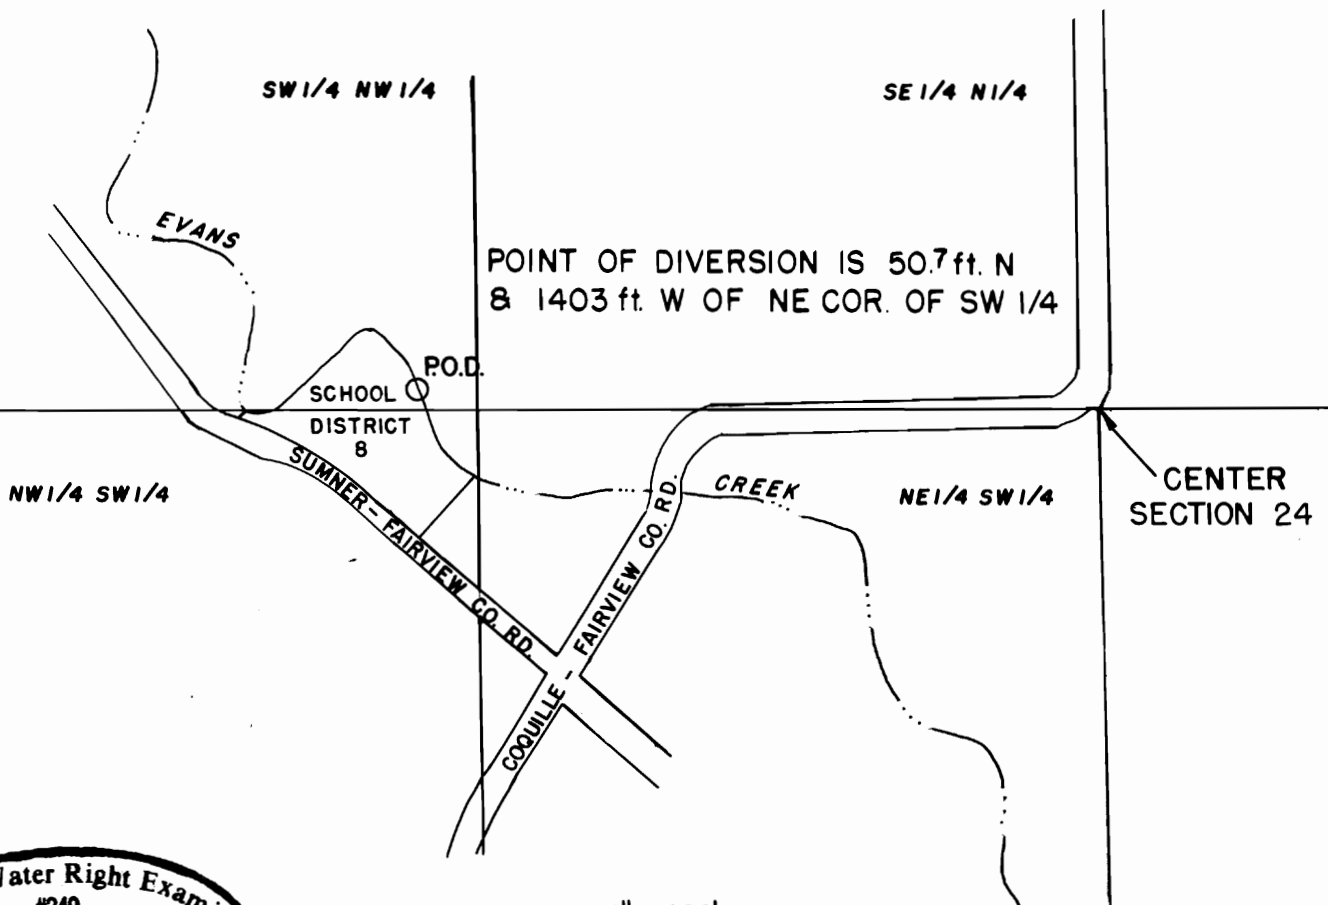

SCALE: 1" = 400'

FINAL PROOF SURVEY


UNDER

Transfer Application No. 6337..... Permit No. 22258...

IN NAME OF

COQUILLE SCHOOL DISTRICT # 8

T.27 S.R.12W.W.M.

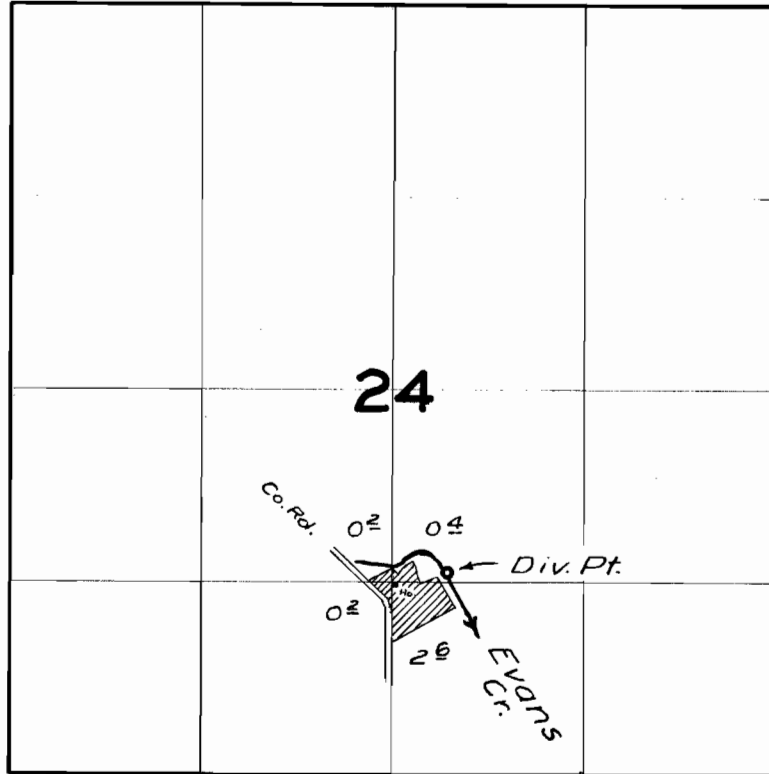

FINAL PROOF SURVEY
UNDER

Application No. 28309 Permit No. 22258
IN NAME OF

Robert O. Gardner

Surveyed May 23 1958, by M. Bisher