


T. 6S., R. 2W., W.M.

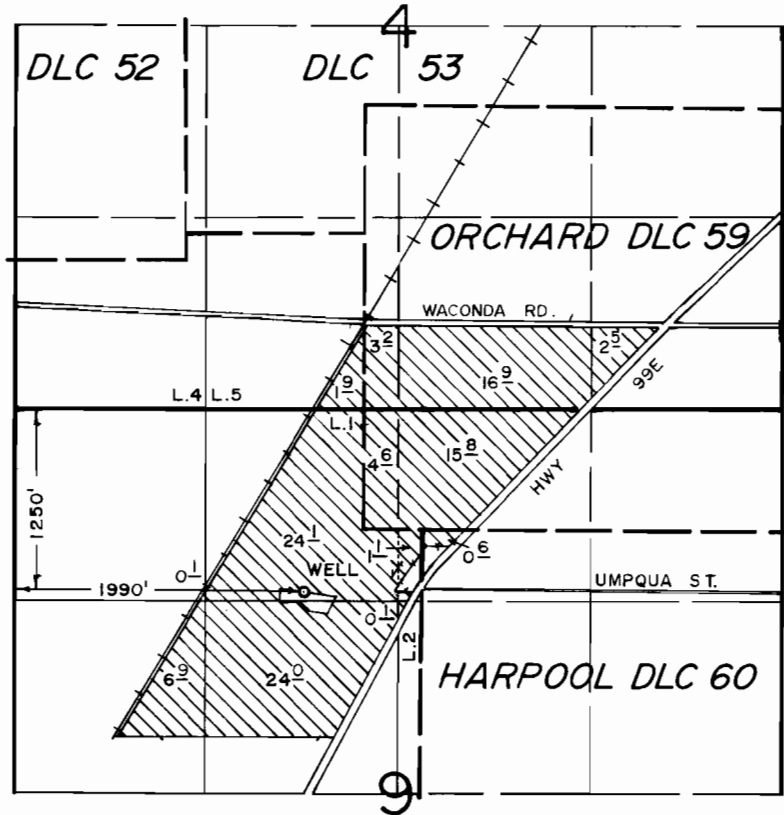

FINAL PROOF SURVEY
UNDER

Application No. G-9357.... Permit No. G-8635.....
IN NAME OF

.....PAUL N. KUDERER.....

Surveyed MAY 12..... 19.80., by B.W. BISHOP.....