


2.3

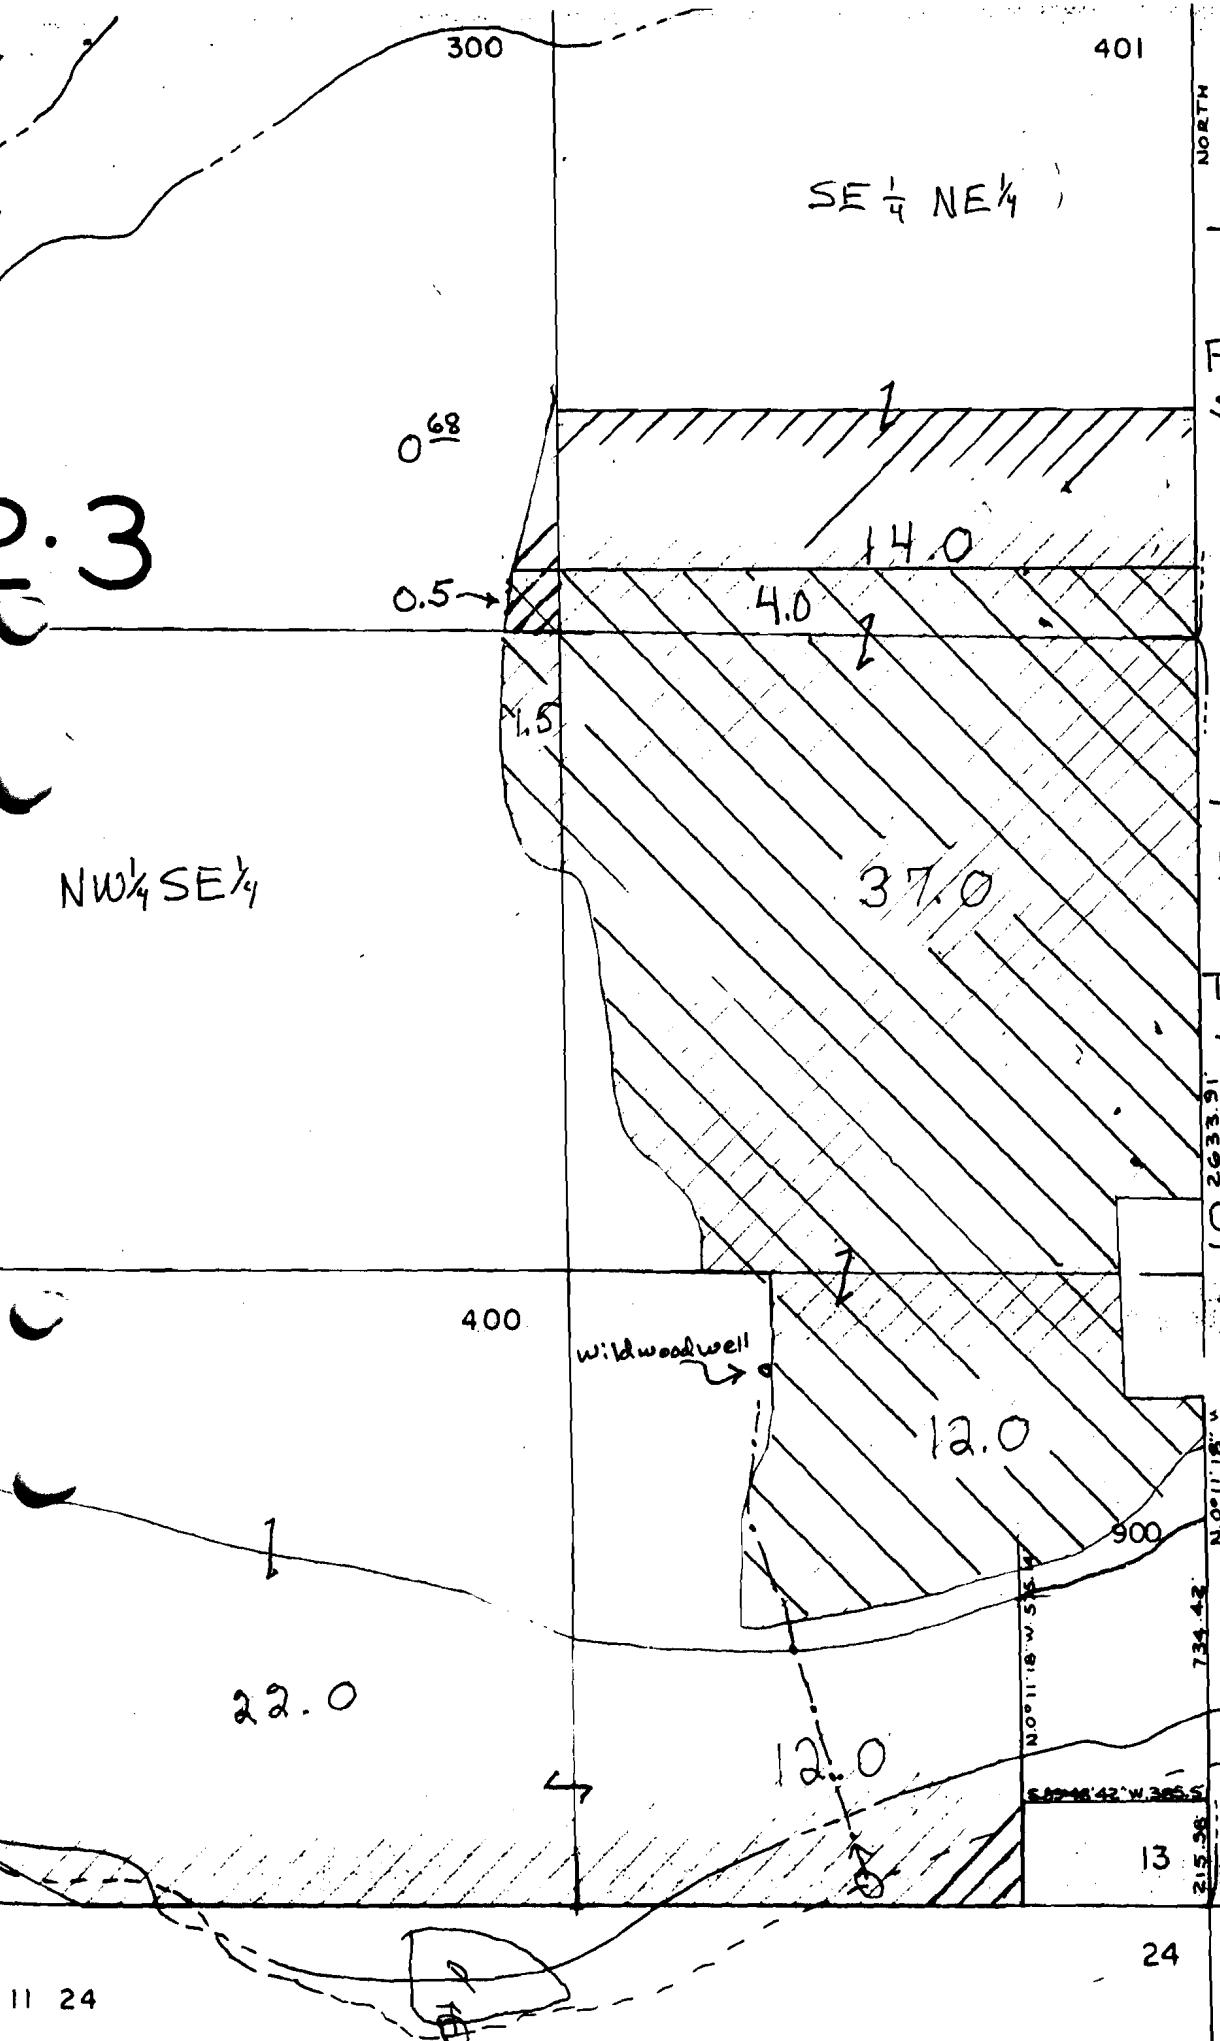

SE $\frac{1}{4}$ NE $\frac{1}{4}$

401

NORTH

N
1" = 400'

T. 14 S., R. 11 E., W.M.
Section 13

Final Proof Map
Supplemental Irrigation

2
4
MOD
SEE
X X
Supplemental

NW $\frac{1}{4}$ SE $\frac{1}{4}$

This right was
formerly recorded
at certificate 57439

Transfer of this right
to its mapped
location was
confirmed at the
approval of Squaw
Creek Irrigation
District's Remapping
Petition.

Bob Main (OWRD)
Feb. 20, 1997

C-57439
SUPERSEDED
BY C-74138

was permit
G-5186