

58965  
74141

T.14 S., R.12 E. w.m.  
Section 18 1" = 400'

# SQUAW CREEK IRRIGATION


SECTION 18 T.14S. R.12E.

DESCHUTES COUNTY

1" = 400'

Final Proof map for supplemental irrigation  
of 166.8 acres

This right was formerly recorded as  
Certificate 58965, and was confirmed at its  
present place of use at the approval of  
Squaw Creek Irrigation District's remapping petition  
Bob Main (DWRD)  
March 5, 1997

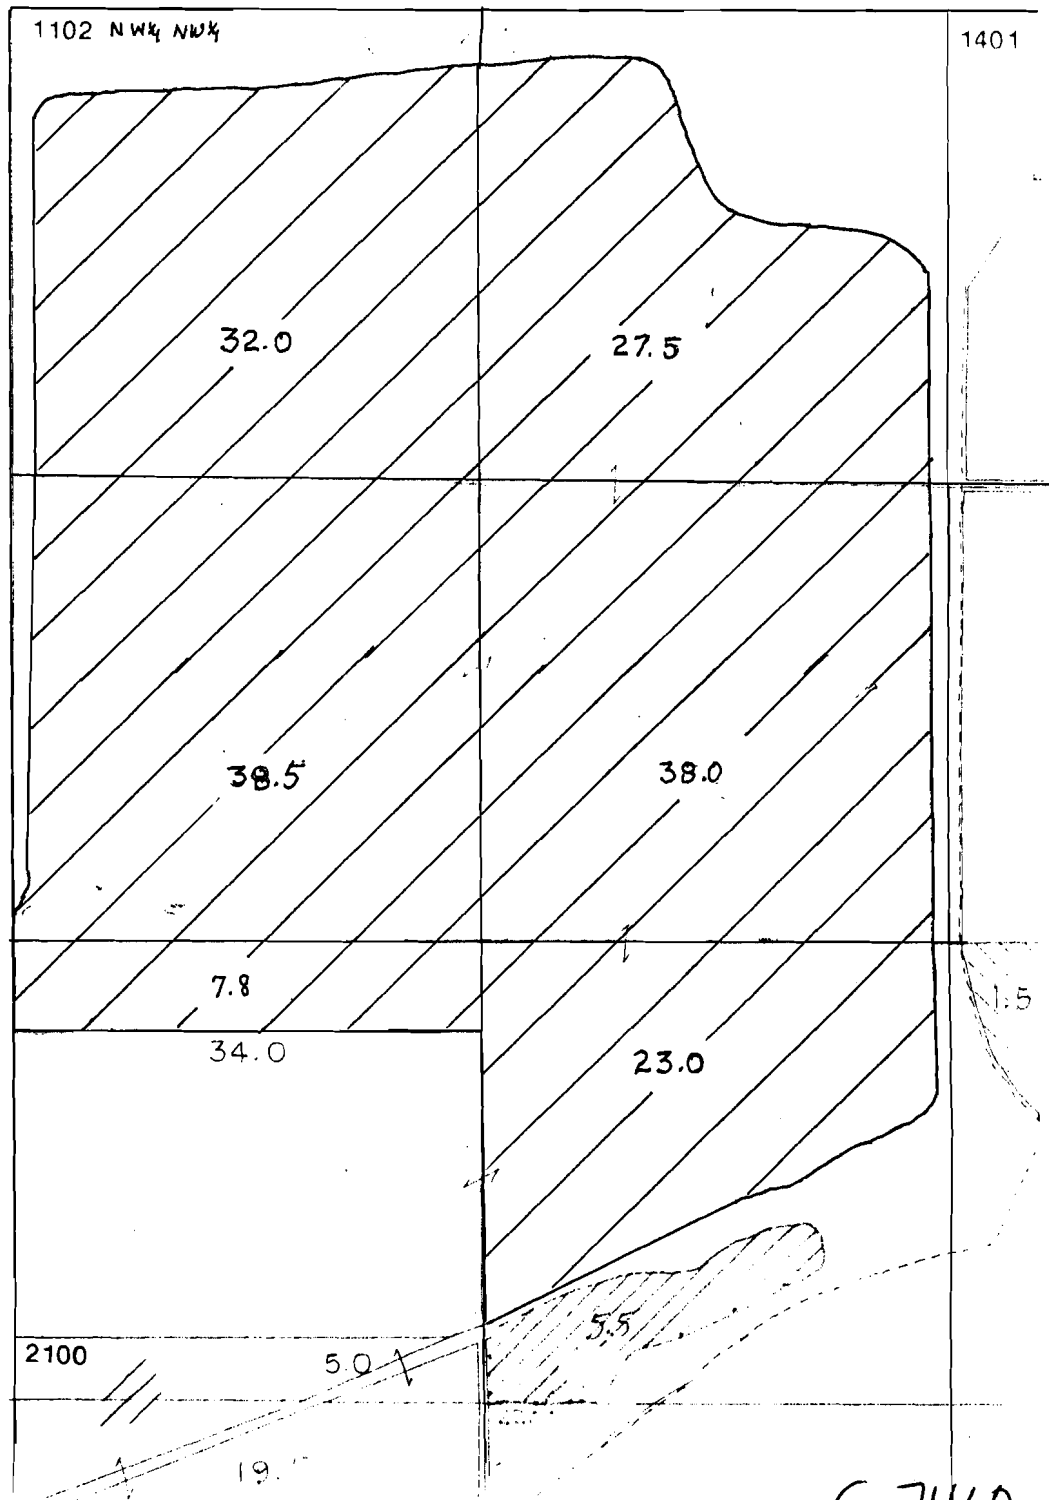

G-7460