


# T.15S. R.10E. W.M.

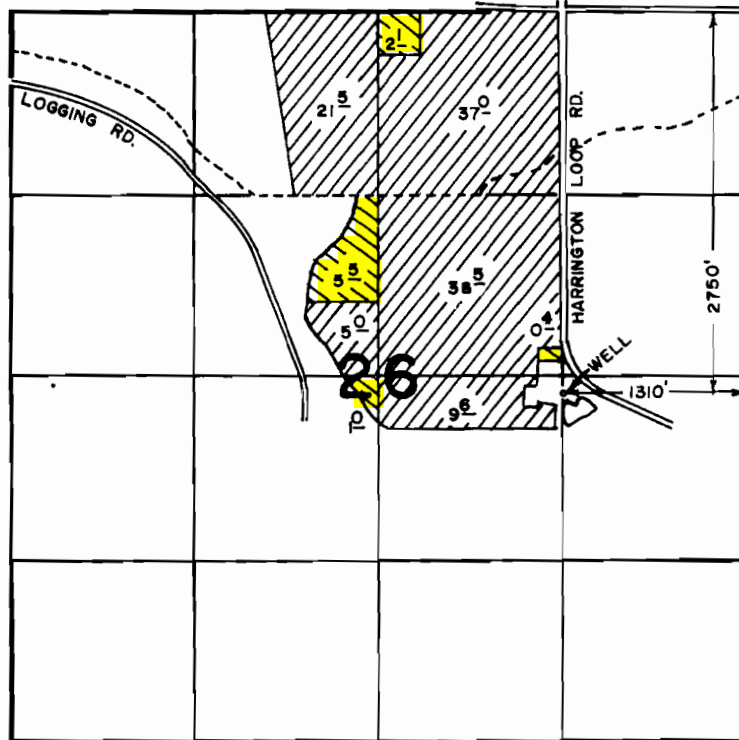

## FINAL PROOF SURVEY UNDER

Application No. G-7621... Permit No. G-7092.....  
IN NAME OF

CHARLES R. TOPPING

Surveyed MAY...14... 1980., by L.H. NUNN.....