



T.15S. R.11E. WM.

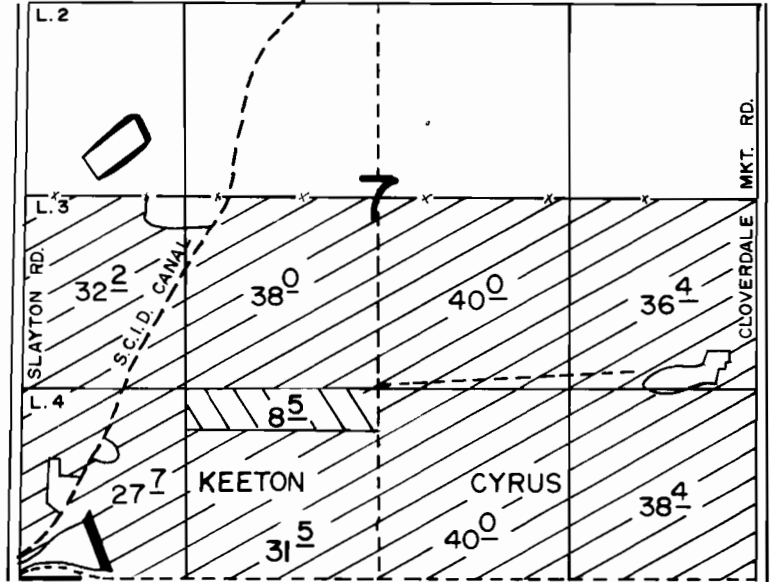

T.15S. R.10E. WM.

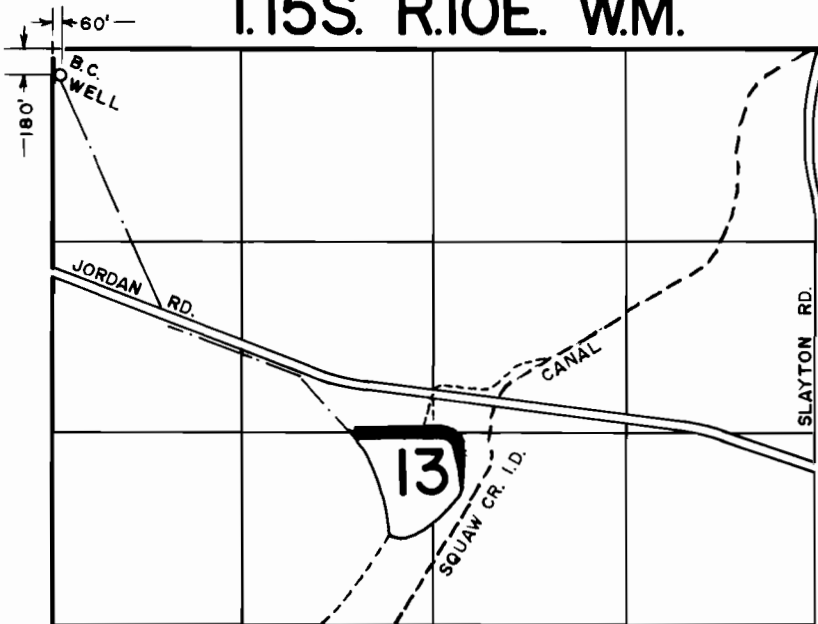

FINAL PROOF SURVEY UNDER

Application No. G-7275. Permit No. G-6857.....
 IN NAME OF

ARLAND T. KEETON & KEITH CYRUS

Surveyed APR. 29. 1980., by L.H. NUNN.....