

UNITED STATES
DEPARTMENT OF THE INTERIOR
BUREAU OF LAND MANAGEMENT

R2542
74169


RECEIVED
JAN 24 1968
STATE ENGINEER
LAND DIVISION

SECTION

Oregon State Water Filings

TOWNSHIP 28S, RANGE 15E, W. M.

North DRY CREEK WATERHOLE

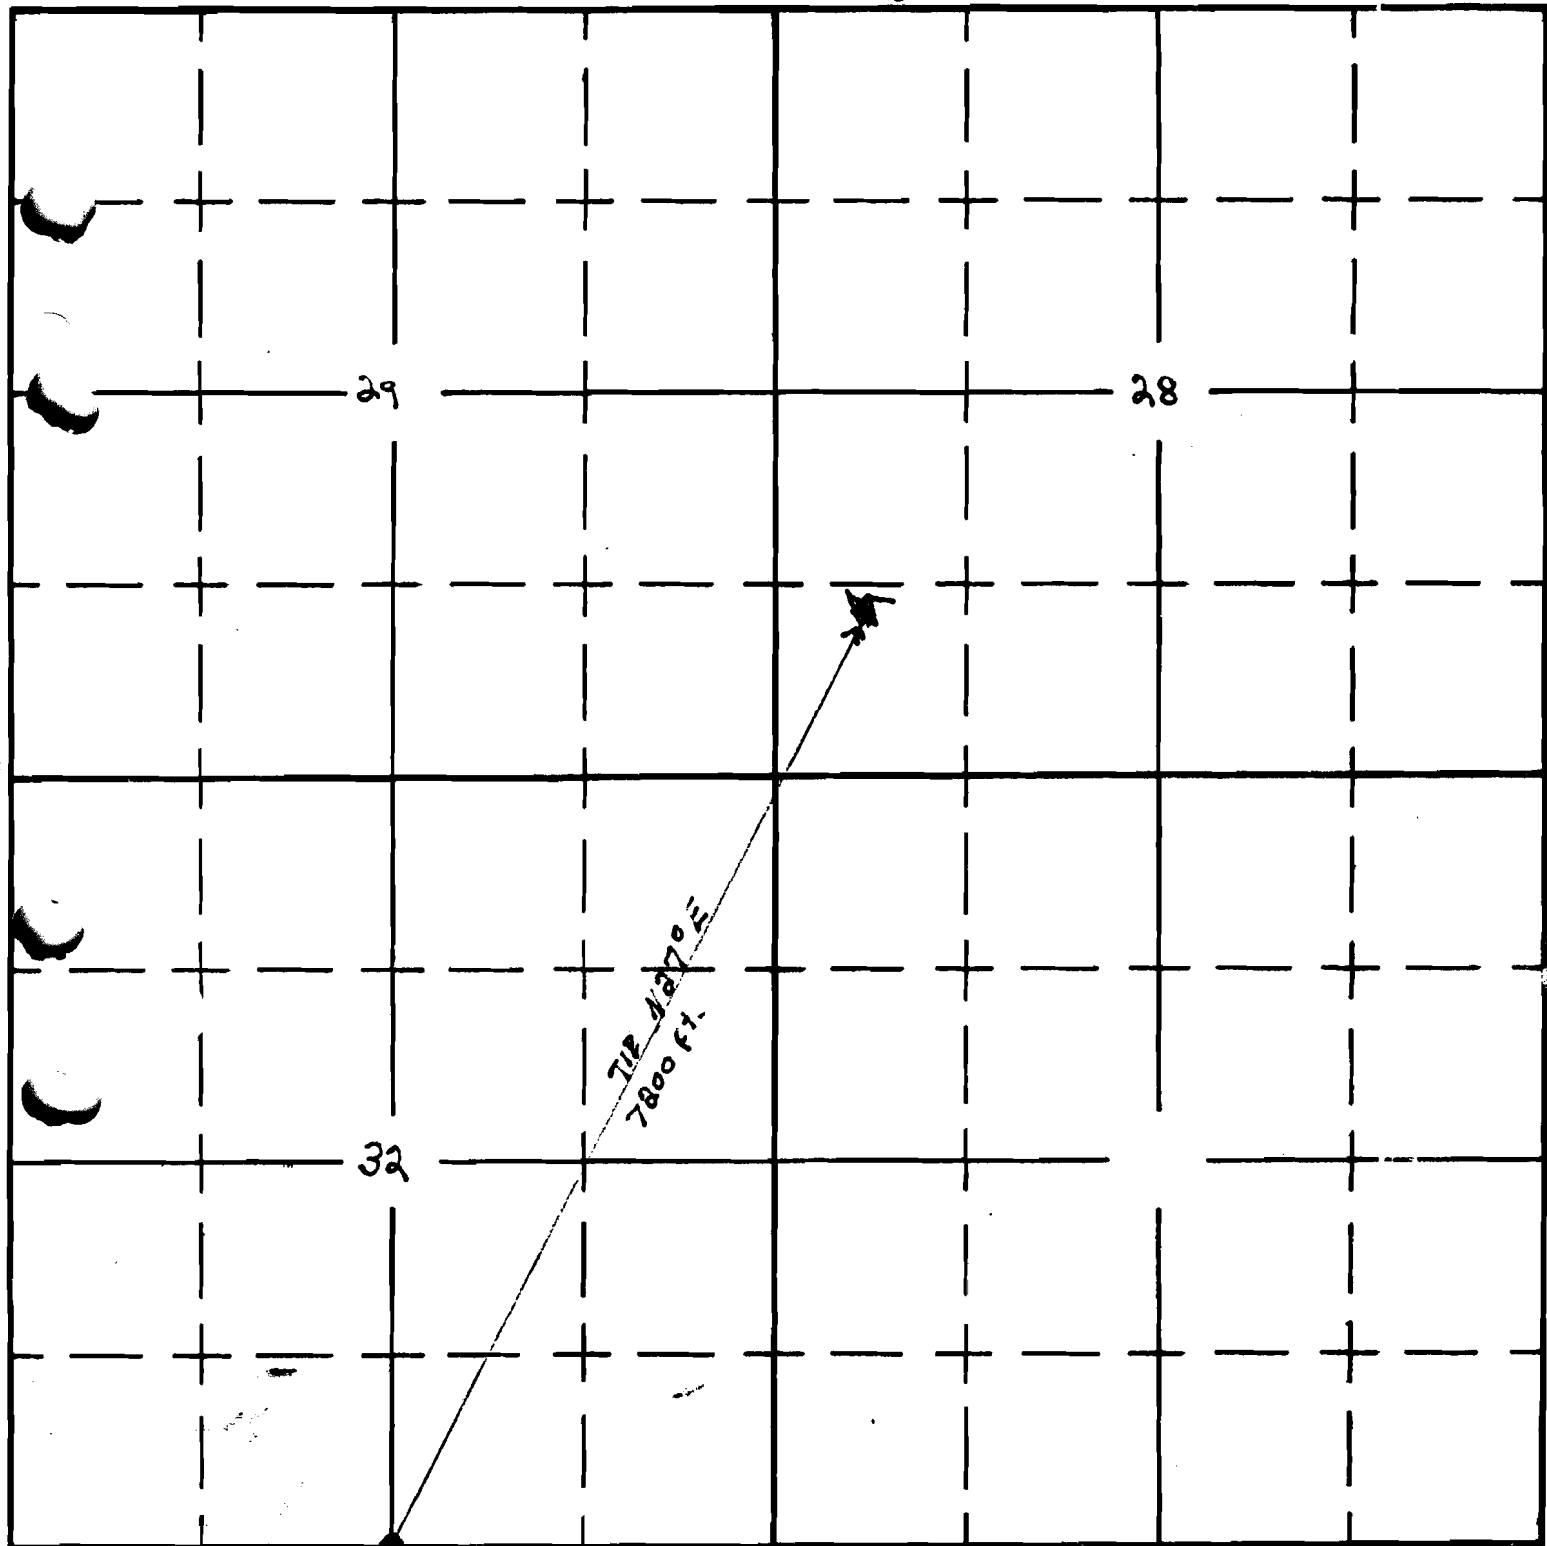

◆ FOUND SURVEY CORNER

South

APPLICATION No. R-34368
PERMIT No. R-2542