

R10031
7473

Form OR-010-7300-2
4/83

UNITED STATES
DEPARTMENT OF THE INTERIOR
BUREAU OF LAND MANAGEMENT

Section
9

Township 28S

Appl. No. R67636


NESE

Range 25E

Permit No. R10031

Will. Mer.

Road Forks Reservoir 4235

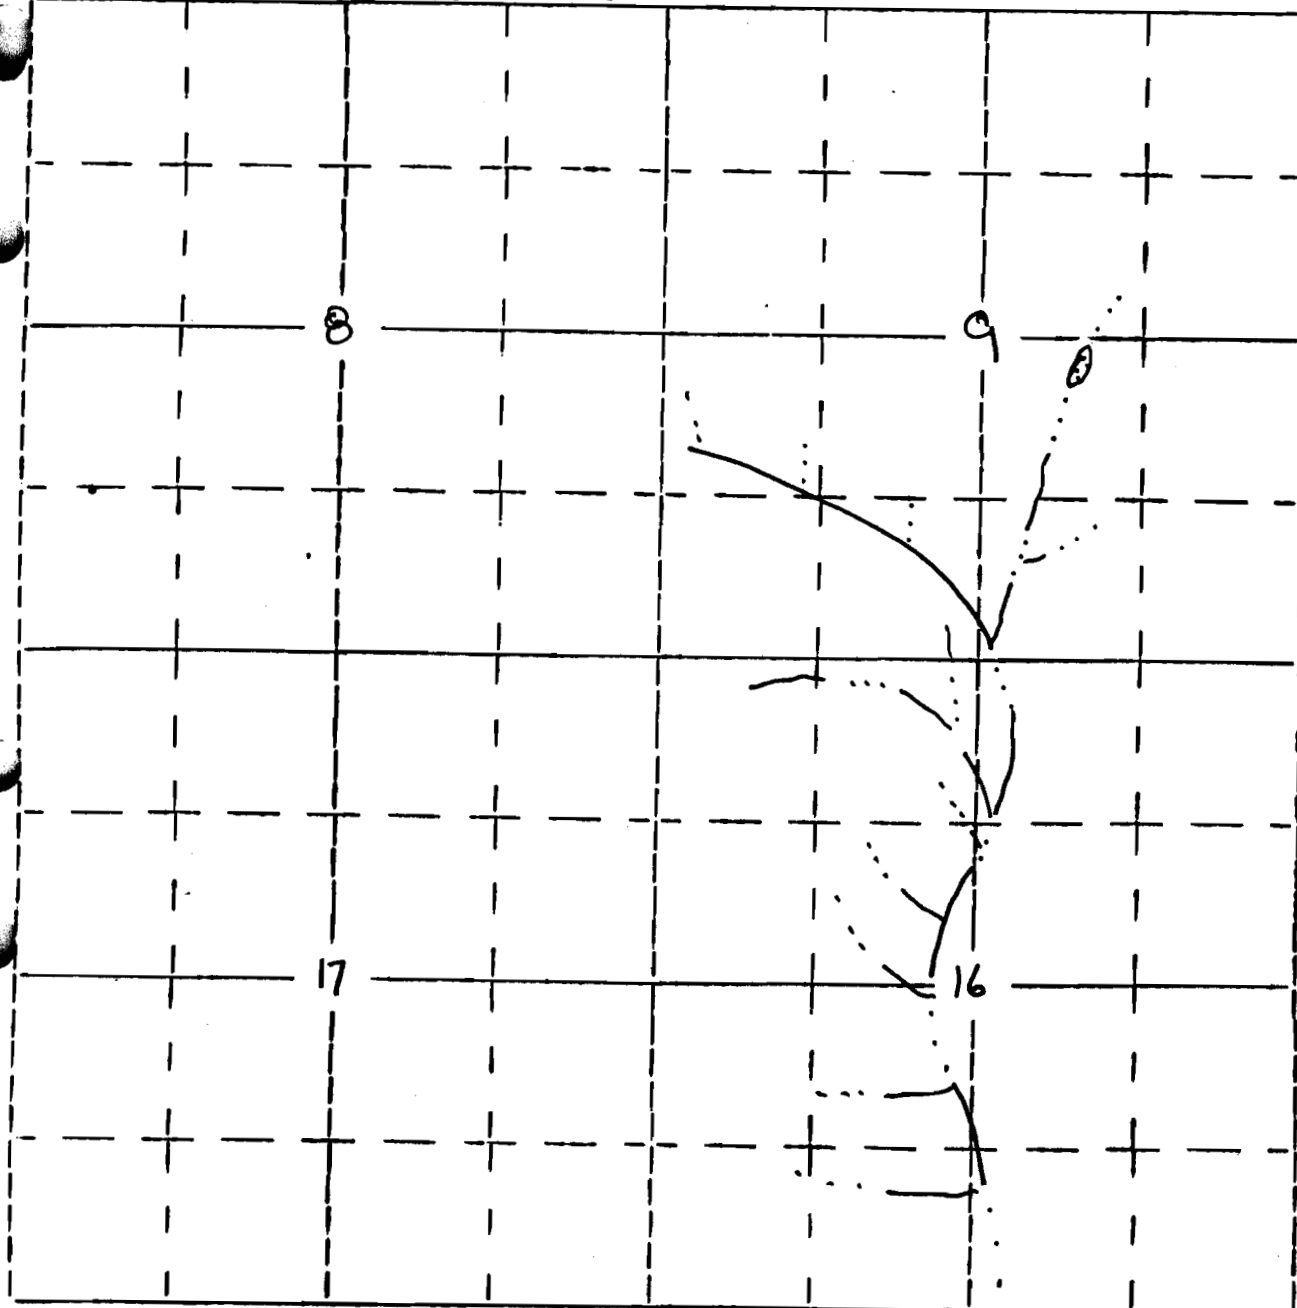

2500' N 1900' W of the SE corner of section 9

RECEIVED

OCT 13 1983

WATER RESOURCES DEPT.
SALEM, OREGON