

R-9498
74174

Form OR-010-7300-2
4/83

UNITED STATES
DEPARTMENT OF THE INTERIOR
BUREAU OF LAND MANAGEMENT

Section 9

Township 28 S.

Appl. No. R67638


SW 1/4 NE 1/4

Range 25 E.

Permit No. R 9498

4 INCHES = 1 MILE

Will. Mer.

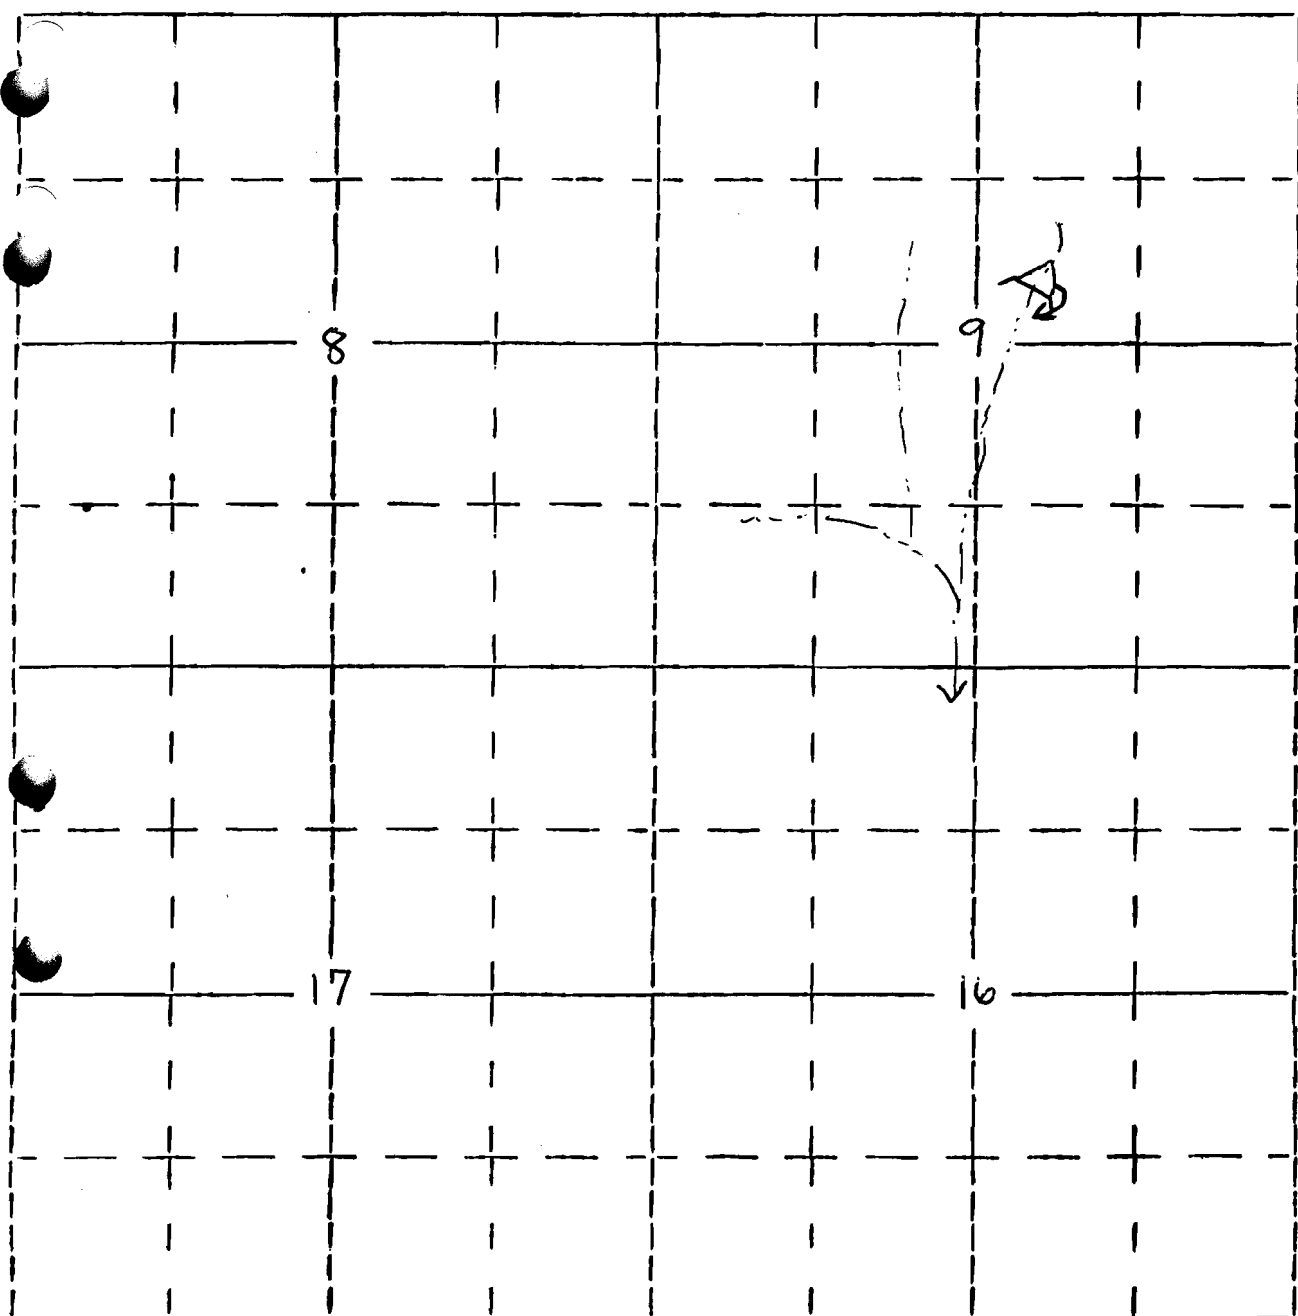

HORSEHEAD CHECK DAM # OR-010-R-4234

THE RESERVOIR IS 2,300 FEET SOUTH, AND 2,100
FEET WEST OF THE NORTHEAST CORNER OF SEC. 9