
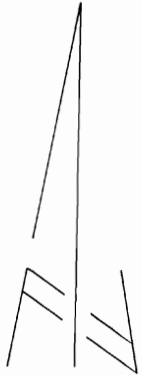


T. 20S., R. 35E., W.M.

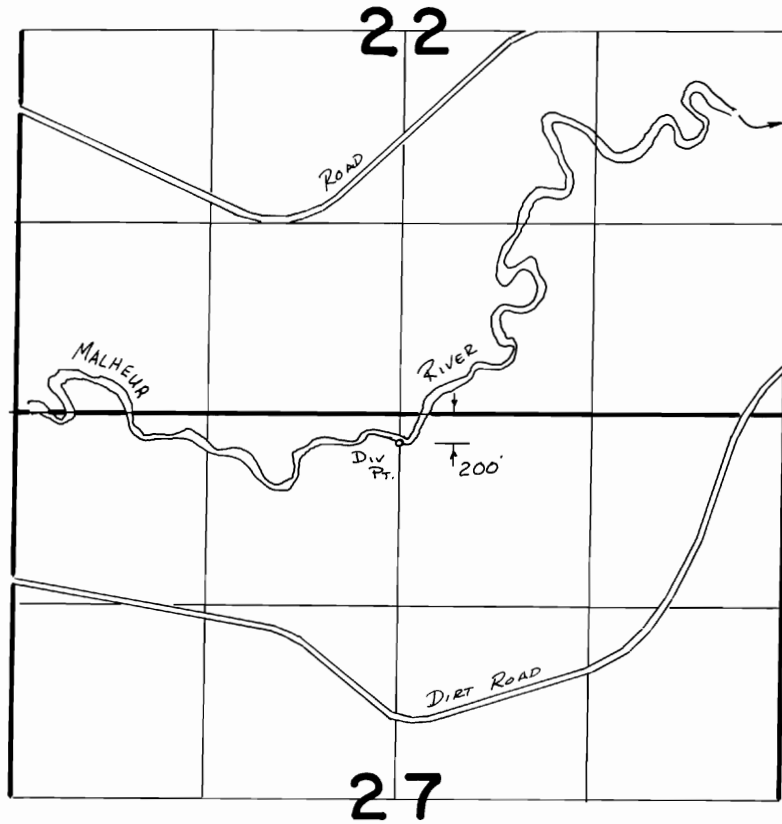

Scale 1" = 1320'

**FINAL PROOF SURVEY**  
UNDER

**TRANSFER 4873**  
IN NAME OF

**PATRICK O'TOOLE**

Surveyed ...5.9..... 1988, by B.S. James.....