


T.38 S., R.6 W., W.M.

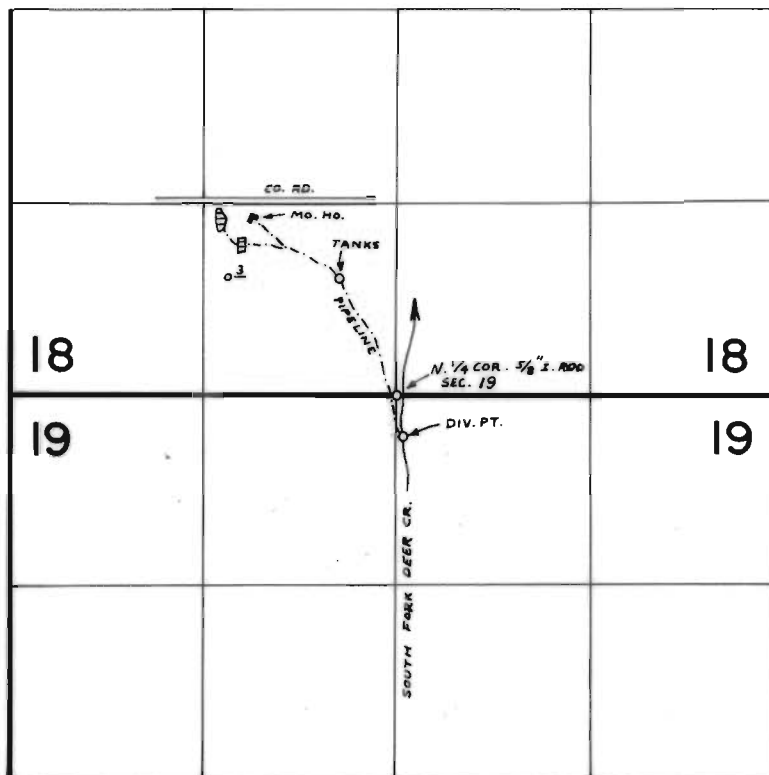

DIV. PT. LOC.: 280' S. & 90' E. FROM N. 1/4 COR. SEC. 19

FINAL PROOF SURVEY
UNDER

Application No. 49532 Permit No. 37075
IN NAME OF

PHYLIS A. VIGIL

Surveyed JUL. 18 1978, by B. SUND