

DLC 39

MINERS CK.

CARIS CREEK

FORMER P.O.D.

RECEIVED

AUG - 9 1999

WATER RESOURCES DEP.
SALEM, OREGON

POINT OF DIVERSION

1670' NORTH & 170' EAST
FROM SW CORNER SEC. 30

IRRIGATION DITCH

**FINAL
PROOF
SURVEY****CHANGE IN
POINT OF
DIVERSION**C-16291, C-16293,
C-16299, C-32942

CARIS CREEK

T-7263

C 16299

C 16299

DLC 40

C 32942

C 16291
7 ACRESC 32942
5 ACRESSUMP /
RESERVOIRC 32942
4 ACRES

FORMER P.O.D.

C 16293
2.3 ACRESC 16293
1.7 ACRES

DLC 38

T.37 S.

R. 5 W.
W.M.

R. 4 W.


UNDER T - 7263

IN NAME OF:
CHERYL L. SHAW**SURVEYED: JULY 16, 1999**

BY:

JONATHAN C. SPERO C.W.R.E. 123
1002 KINCAID RD./P.O. BOX 16
WILLIAMS, OREGON 97544
PH. (541) 846-6845THIS MAP IS FOR THE PURPOSE OF
IDENTIFYING THE LOCATION OF THE
WATER RIGHT ONLY AND IS NOT IN-
TENDED TO PROVIDE LEGAL DIMEN-
SIONS OR LOCATIONS OF PROPERTY
OWNERSHIP LINES.

SCALE: 1" = 400'

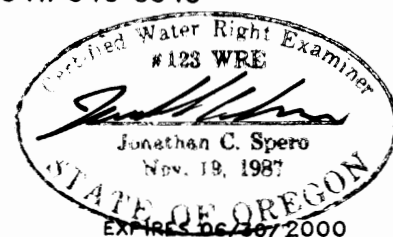

