


11253

Per 7964
7419

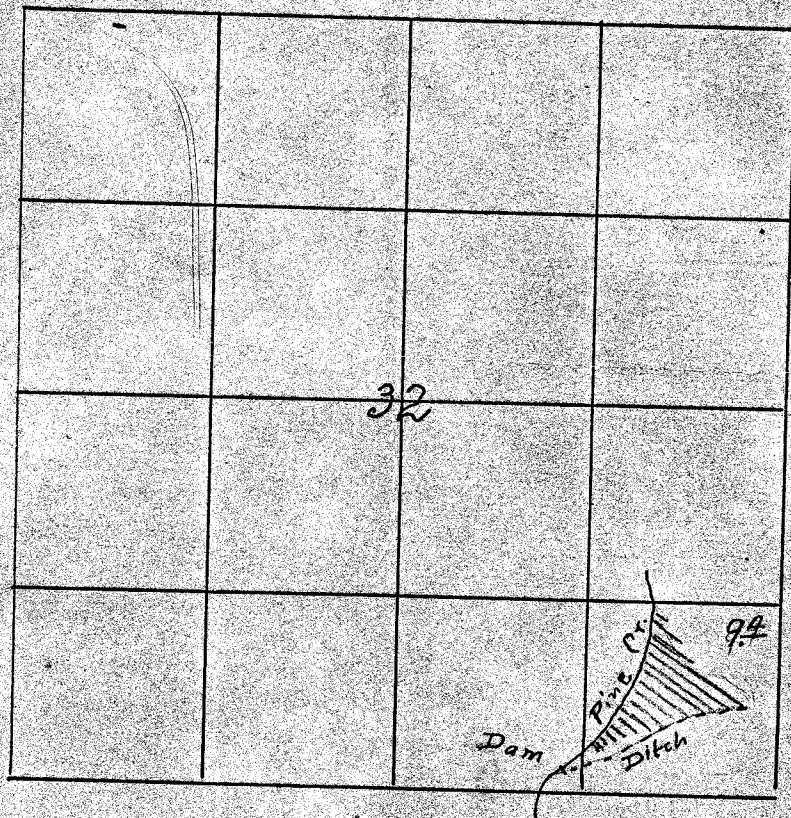

Sec. 32 T.12 S. R.24 E.

To accompany application of Peter C. Truchot

Application No. 11529
Permit No. 7964

11253