
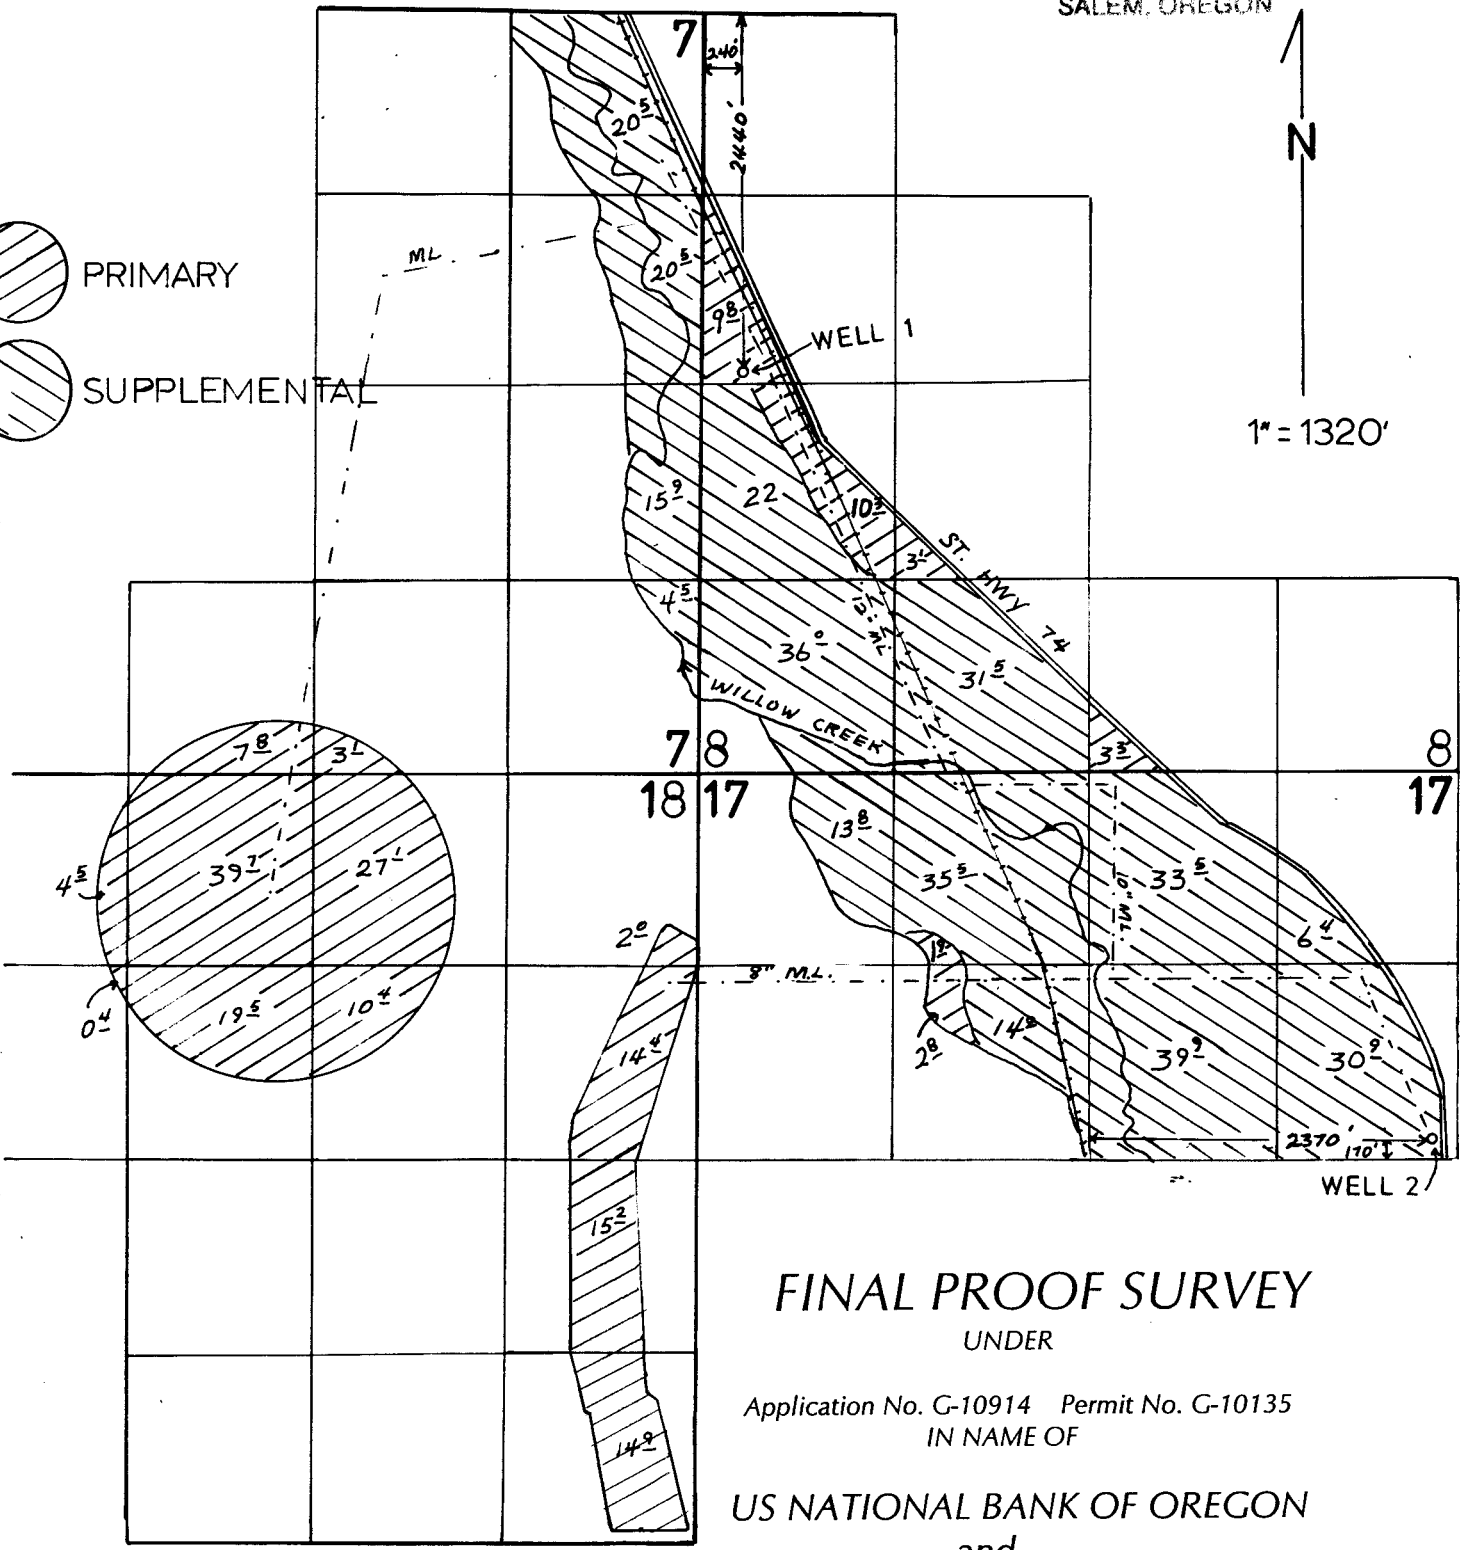
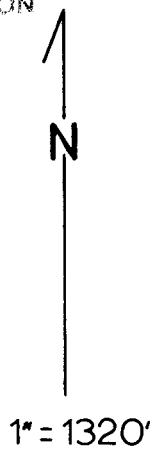


T. 2 N., R. 23 E., W.M.

G-10135
RECEIVED 74196
FEB 28 1997

WATER RESOURCES DEPT.
SALEM, OREGON

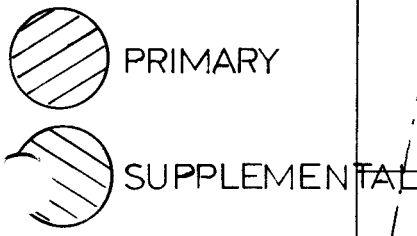

FINAL PROOF SURVEY
UNDER

Application No. G-10914 Permit No. G-10135
IN NAME OF

US NATIONAL BANK OF OREGON
and
DIAMOND PROPERTIES INV. COMP. LLC

Surveyed 9 - 8, 1993, by J. Miller