


T. 9S., R. 39E., W. M.

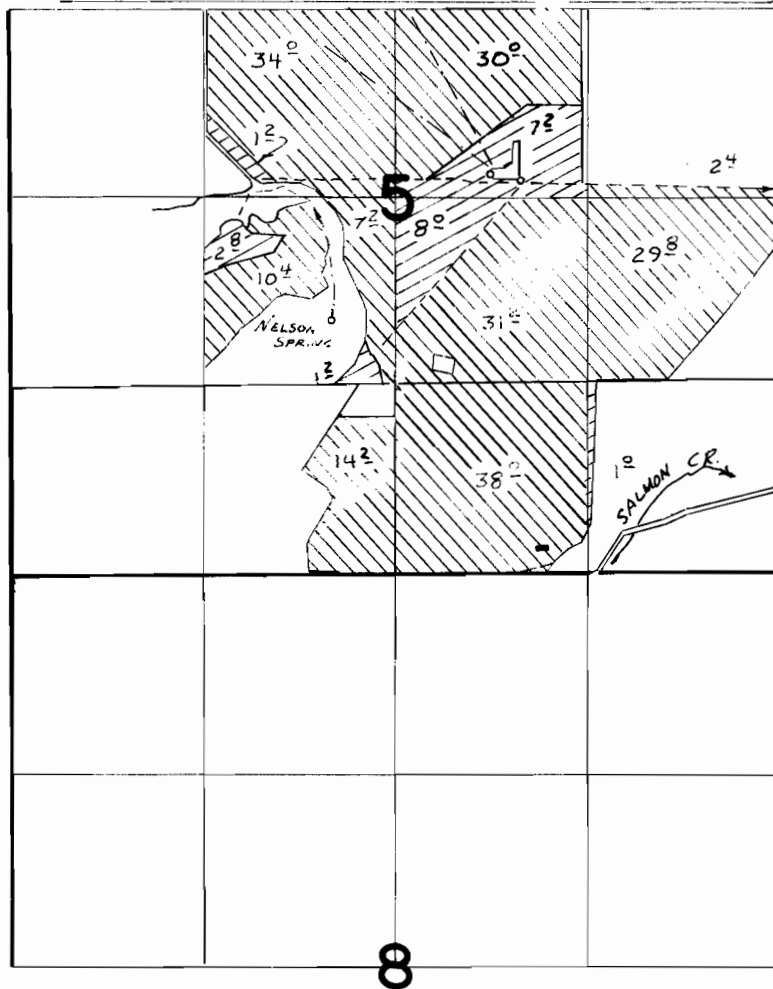

SUPP.L.



PRIM.

NELSON SPRING LOC: 850' S. & 440' W. FROM CENTER COR. SEC 5

FINAL PROOF SURVEY
UNDER



SCALE 1" = 1320'

Application No. **57452** Permit No. **43376**...
IN NAME OF

.....**JOSEPH O. RUDI**.....

Surveyed **5.23**..... 19**84**., by **V.L. Church**.....