


T. 40S., R. 19E., W.M.

44110
74206

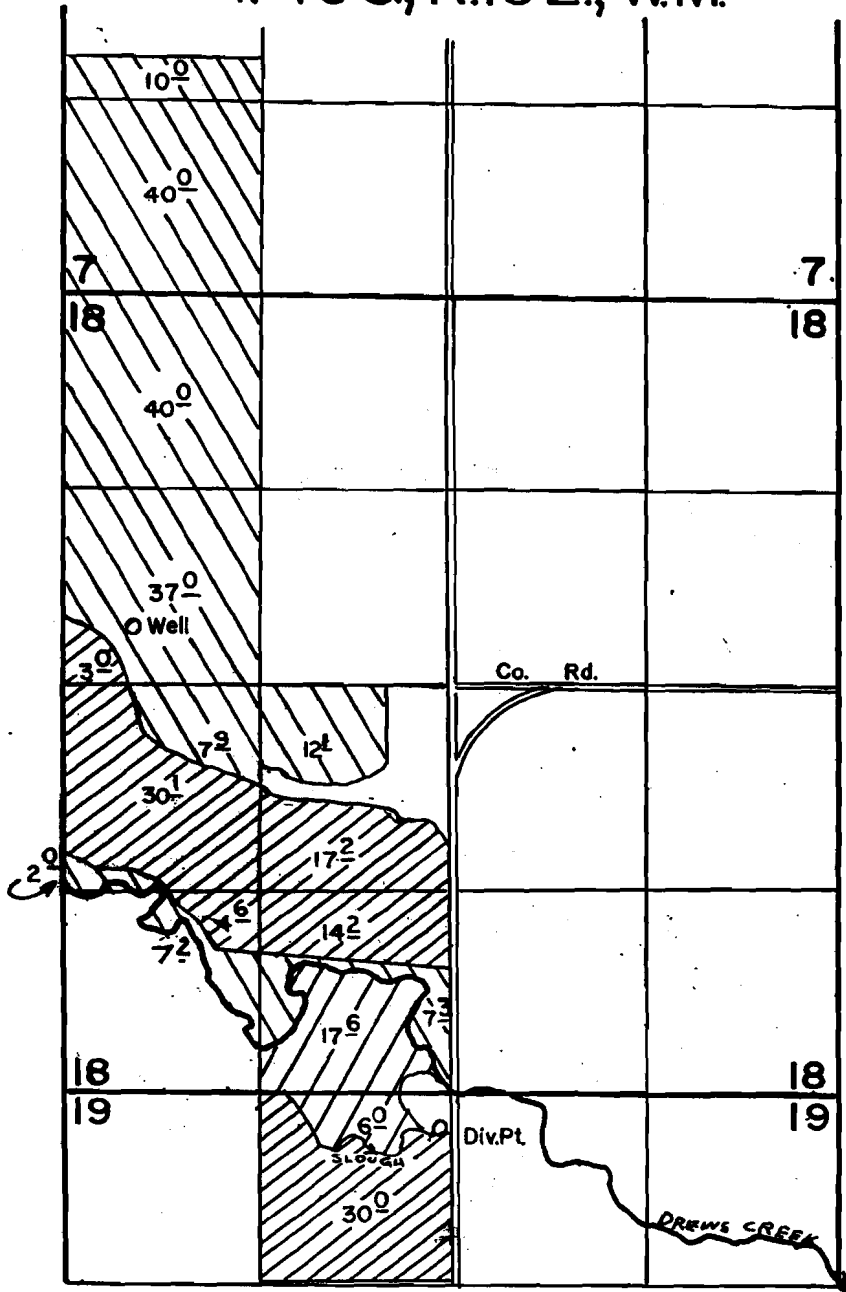

Well Located 3150' N & 490' E, Div. Pt. Located 250' S & 2550' E, Both From SW Corner Section 18

FINAL PROOF SURVEY

UNDER

SCALE: 1"=1320'

57986

44110

Application No. G-8964 Permit No. G-8571

IN NAME OF



Permit 44110

Permit G-8571 Primary

Permit G-8571 Supplemental

KAY C. CLARK

Surveyed OCT. 17, 1987, by B.S. JAMES