


T. 4 S., R. 48 E., W.M.

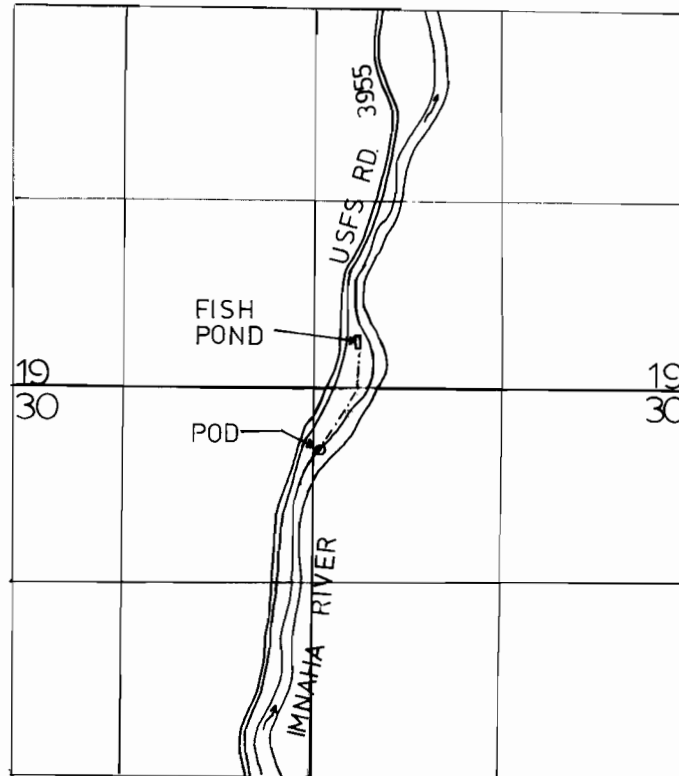

1" = 1320'

POD - 426' S. AND 20' E. FROM THE S. 1/4 COR.
OF SECTION 19.

FINAL PROOF SURVEY

UNDER

Application No. 63244 Permit No. 46466
IN NAME OF

OREGON DEPARTMENT OF FISH AND WILDLIFE

Surveyed 5-28, 1992, by J. MILLER