
90684

T. 34 S., R. 3 W., W.M.

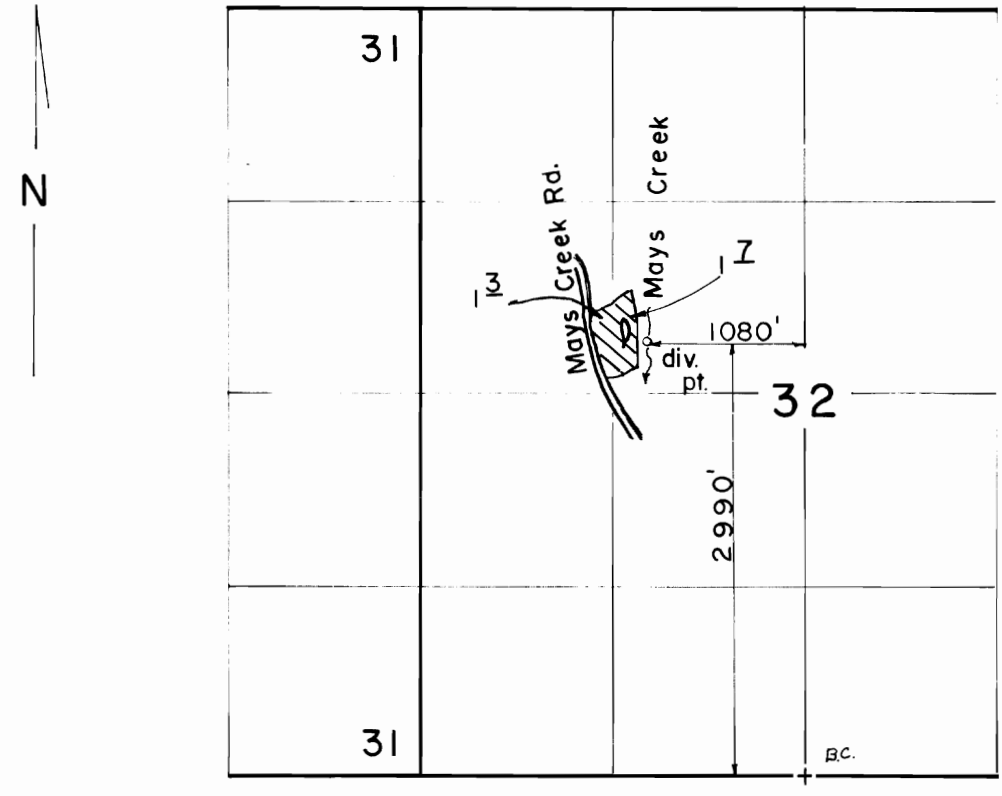

Scale: 1" = 1320'

FINAL PROOF SURVEY

UNDER

TRANSFER NO. 5123

Application No. ..... Permit No. .....

IN NAME OF

WILLIAM & MEDORA B. NANKERVIS

Surveyed JUN. 7 **19**87, **by** B. S. JAMES

41029-179-91R LMJ