


T.3S. R.4W. W.M.

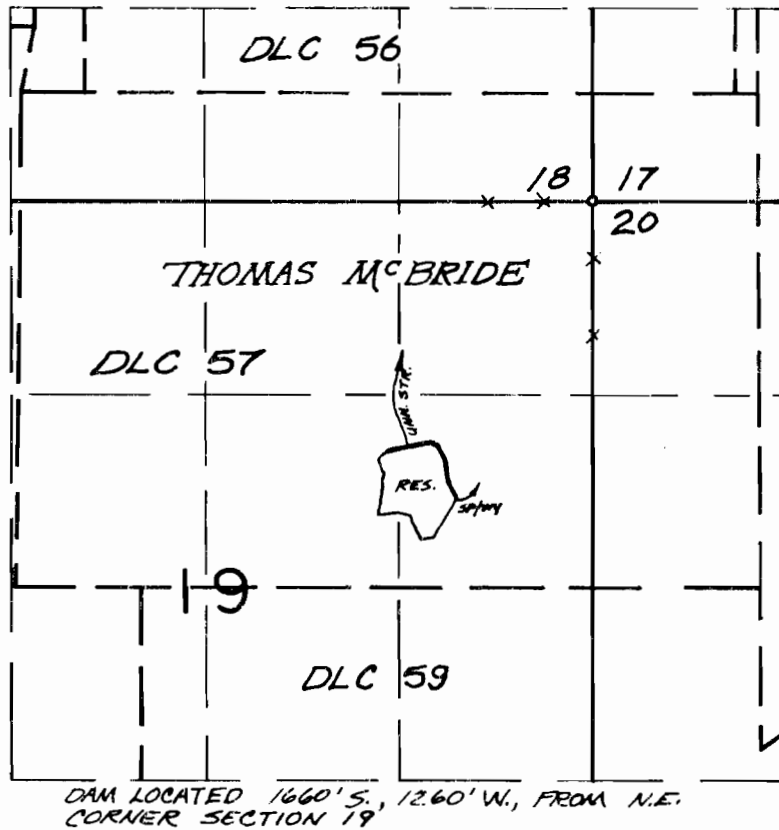

FINAL PROOF SURVEY
UNDER

R 47127 R 5592
Application No. 47128 Permit No. 34938
IN NAME OF

..... OBERG BROTHERS

Surveyed JUNE 13 1974, by L.M. TOLL