

1-187
1961

UNITED STATES
DEPARTMENT OF THE INTERIOR
BUREAU OF LAND MANAGEMENT

RESERVOIR RECEIVED


4361 MAR 17 1997

WATER RESOURCES DEPT.
SALEM, OREGON

Oregon State Water Filings

SECTION
SW 1/4 SW 1/4
NW 1/4 NW 1/4
SEC 20

TOWNSHIP 22 S, RANGE 4 E, W. M.

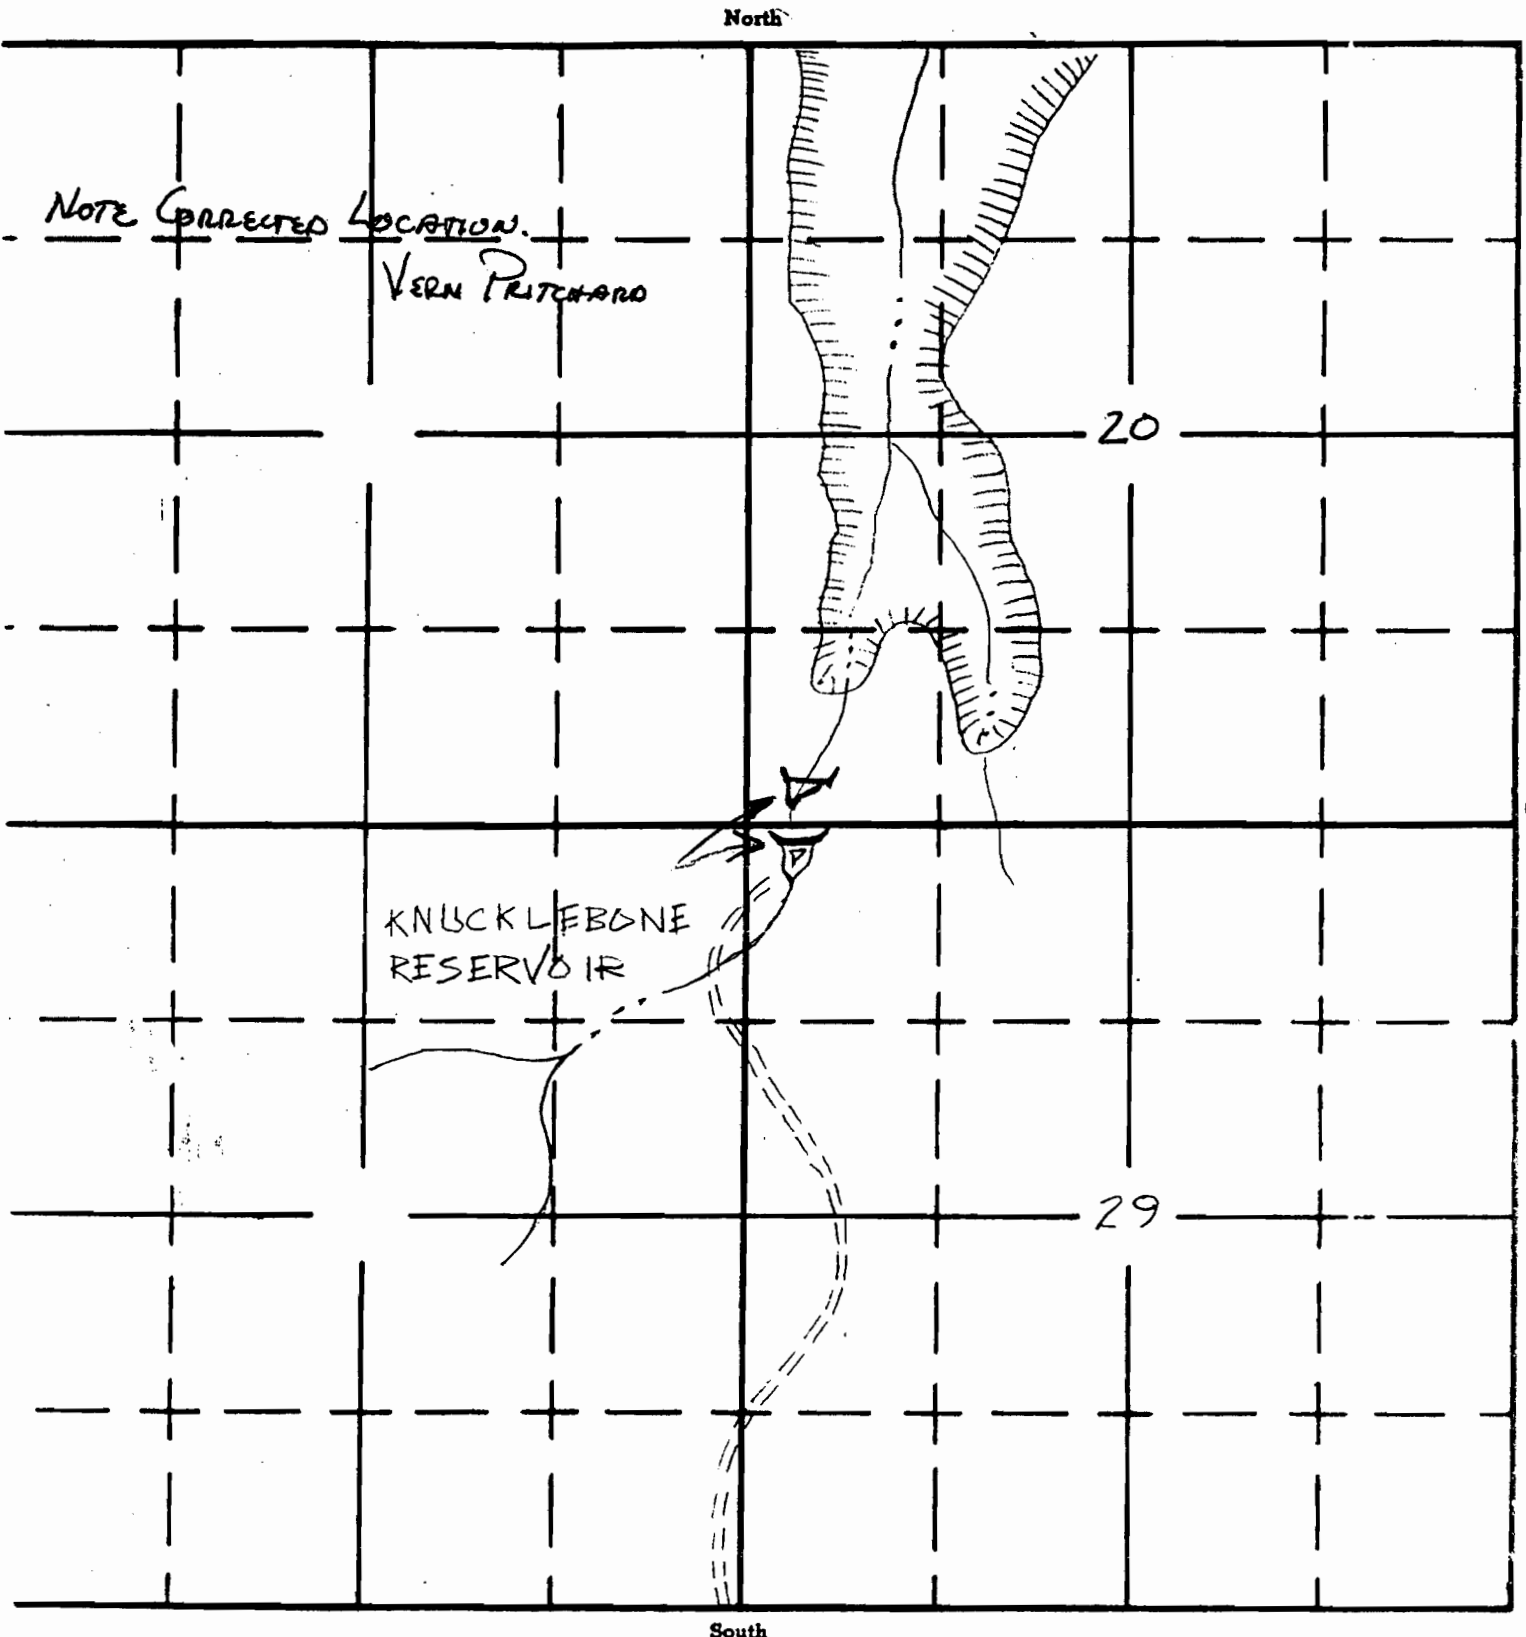

APPLICATION No. R-68869