RECEIVED

MAY - 9 1994

WATER RESOURCES DEPT.
SALEM, OREGON

SECTION 3

SE¼ NW¼ TOWNSHIP 30S RANGE 37E W.M.

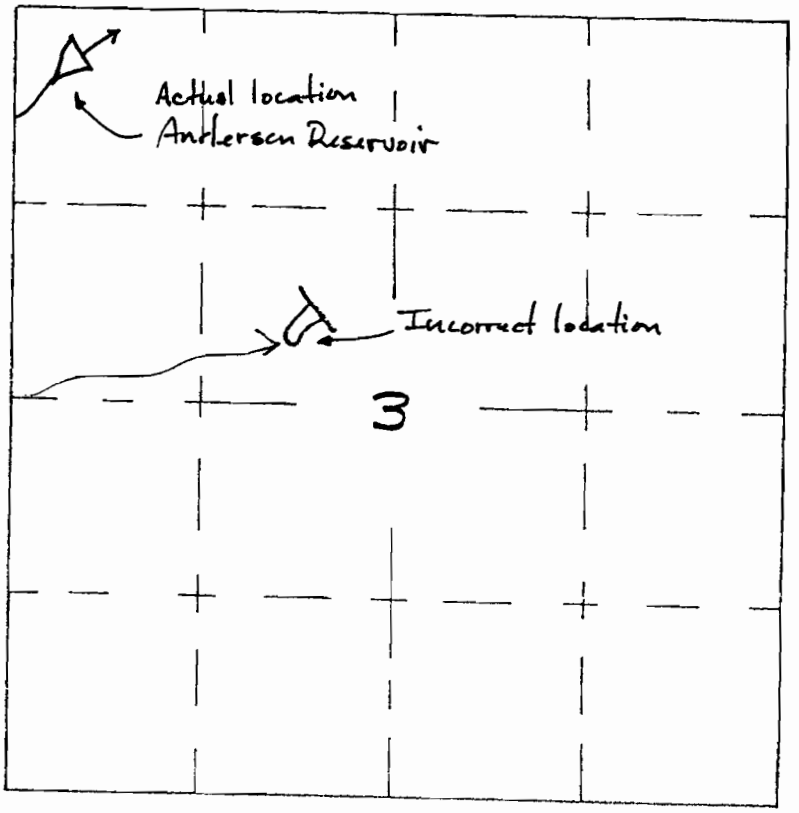

Application No. R59113

Permit No. R 8750

U. S. DEPARTMENT OF THE INTERIOR BUREAU OF LAND MANAGEMENT	
ANDERSON	
DESIGNED	RECOMM.
DRAWN	RECOMM. CHIEF, DIV. OF ENG.
CHECKED	APPROVED
SCALE	
DATE	SHEET OF
DRAWING NO.	

WASH.

SECTION 3

SE¼ NW¼ TOWNSHIP 30S RANGE 37E W.M.

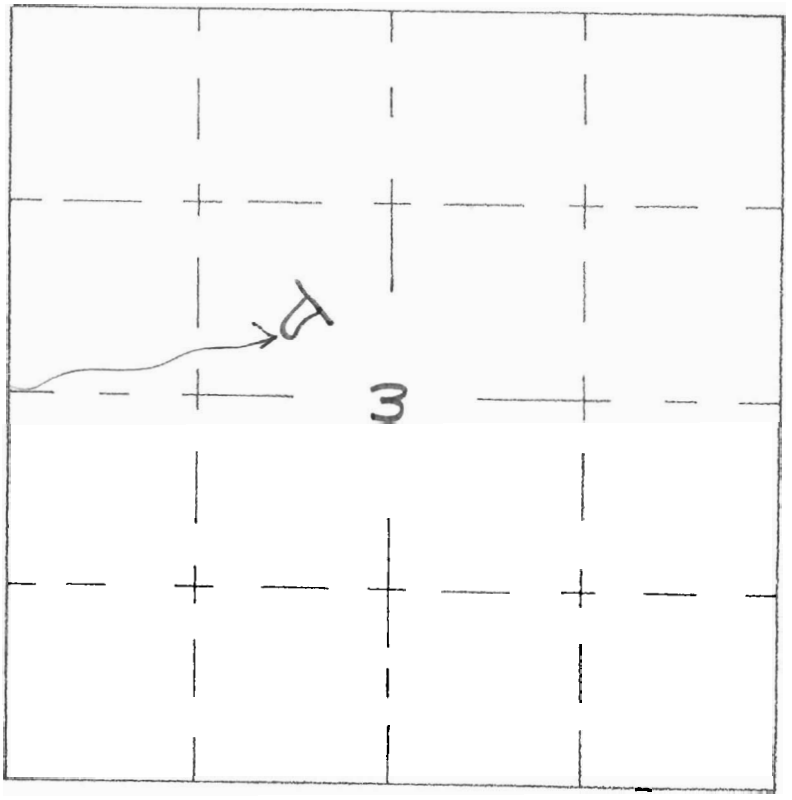

Application No. R59113
Permit No. R 8750

U. S. DEPARTMENT OF THE INTERIOR BUREAU OF LAND MANAGEMENT	
ANDERSON	
DESIGNED	RECOMM.
DRAWN	RECOMM. CHIEF, DIV. OF ENG.
CHECKED	APPROVED
SCALE	
DATE	SHEET OF
DRAWING NO.	

☆GPO— 679-390