

RECEIVED


APR 6 1983

**WATER RESOURCES DEPT.
SALEM, OREGON**

SECTION 20

NE $\frac{1}{4}$ SW $\frac{1}{4}$

TOWNSHIP 37S RANGE 43E W.M.

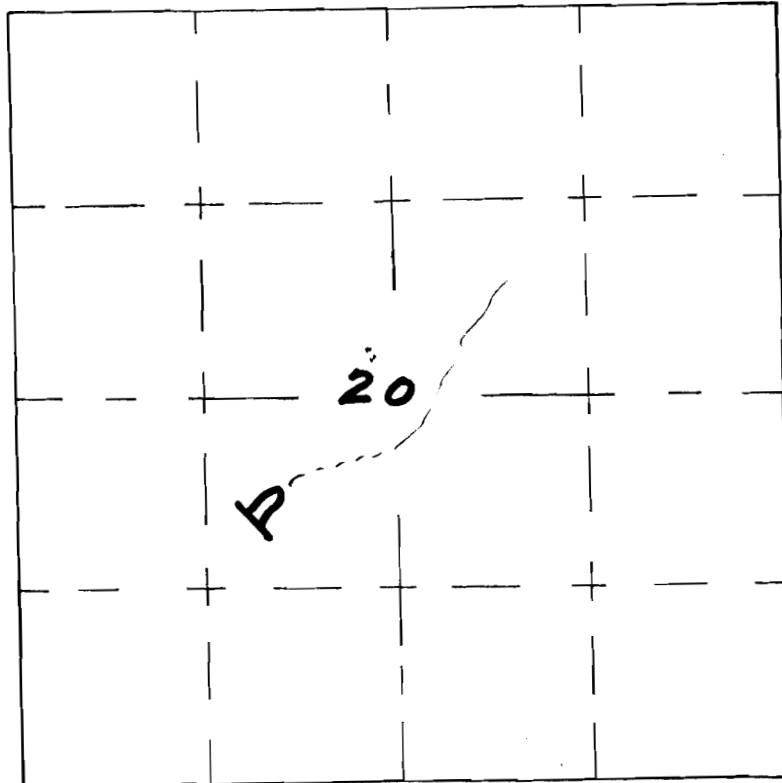

RECEIVED

JAN 14 1983

**WATER RESOURCES DEPT.
SALEM, OREGON**

Cascade Res.

No R59133

Permit No. *R 8766*

RECEIVED
JAN 14 1983
WATER RESOURCES DEPT.
SALEM, OREGON

RECEIVED

MAR 17 1997

WATER RESOURCES DEPT.
SALEM, OREGON

RECEIVED


APR 6 1983

WATER RESOURCES DEPT.
SALEM, OREGON

SECTION 20

NE $\frac{1}{4}$ SW $\frac{1}{4}$

TOWNSHIP 37S RANGE 43E W.M.

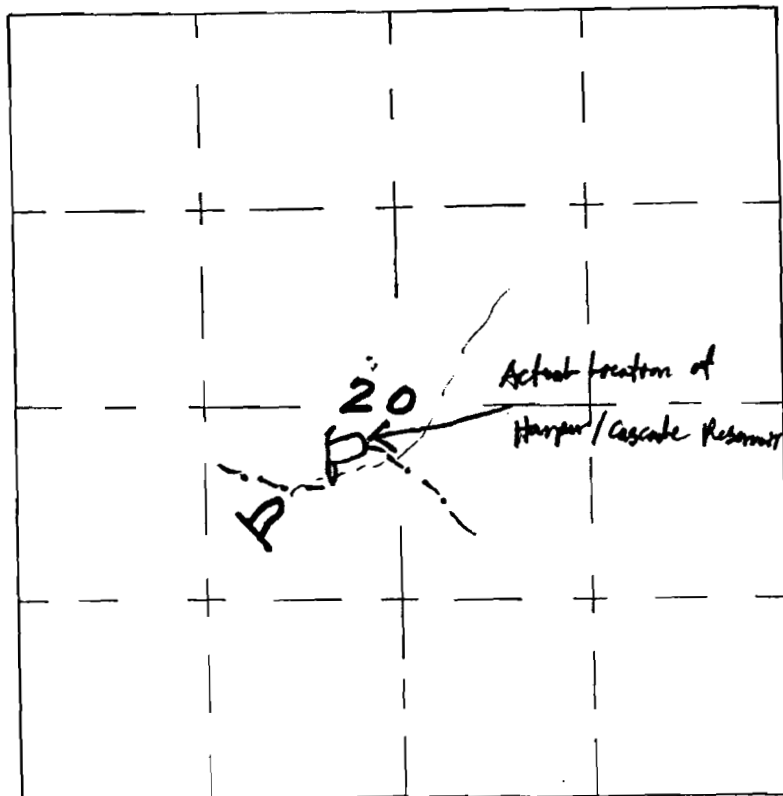

RECEIVED

JAN 14 1983

WATER RESOURCES DEPT.
SALEM, OREGON

Cascade Res.

No R59133

Permit No. R 8766