

1/1
0/1

SECTION

9


Oregon State Water Filings

SW 1/4 SE 1/4

TOWNSHIP 18⁰⁰, RANGE 39^E, W. M.

North

Little Indian

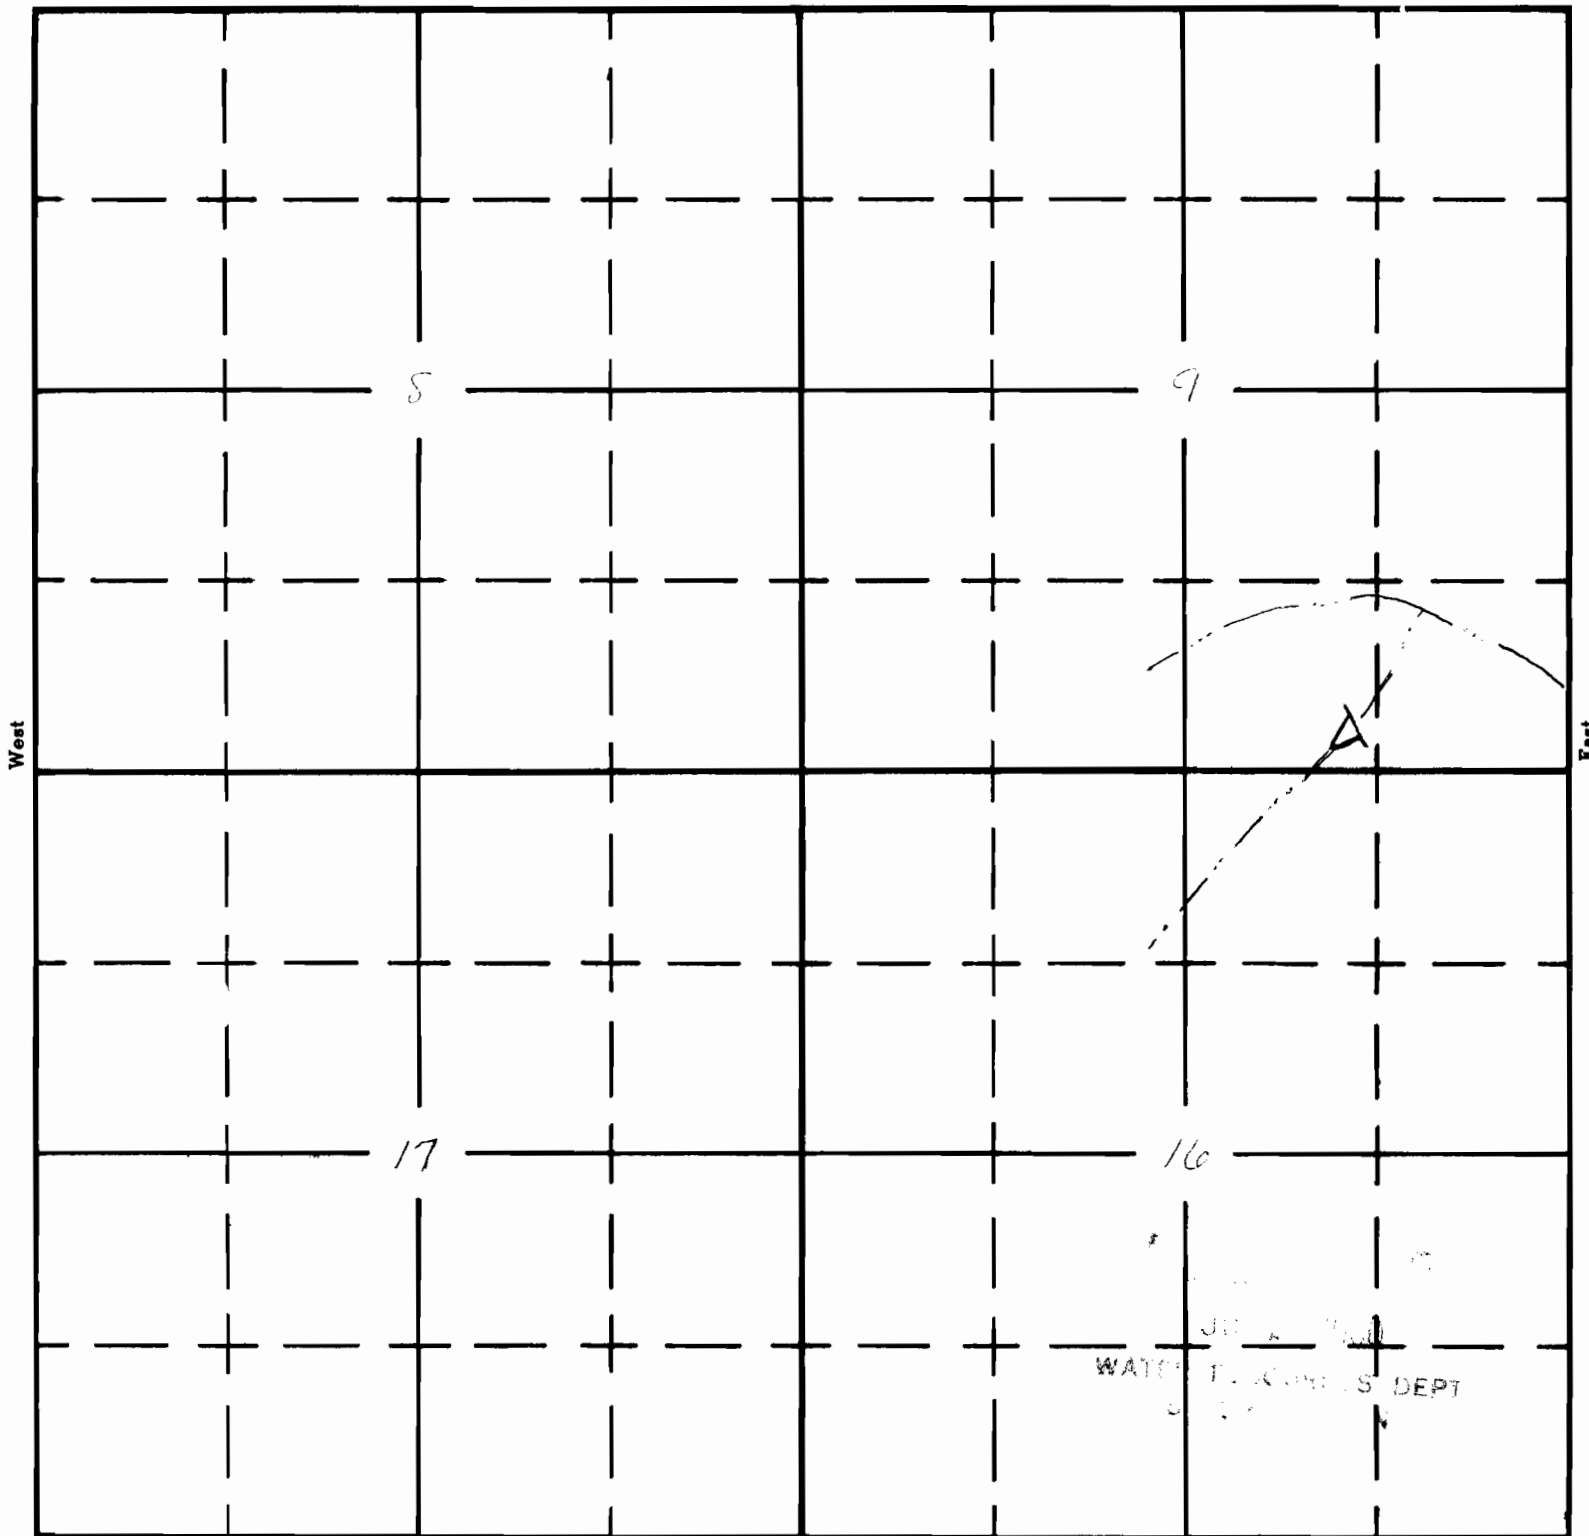

South

APPLICATION No.

PERMIT No.