

-187
1961

UNITED STATES
DEPARTMENT OF THE INTERIOR
BUREAU OF LAND MANAGEMENT

MAR 17 1997

RECEIVED

SEP 30 1983


WATER RESOURCES DEPT.
SALEM, OREGON

Oregon State Water Filings

TOWNSHIP 30 S, RANGE 37 E, W. M.

SECTION
35 NESW

North LAKE RIDGE RES.

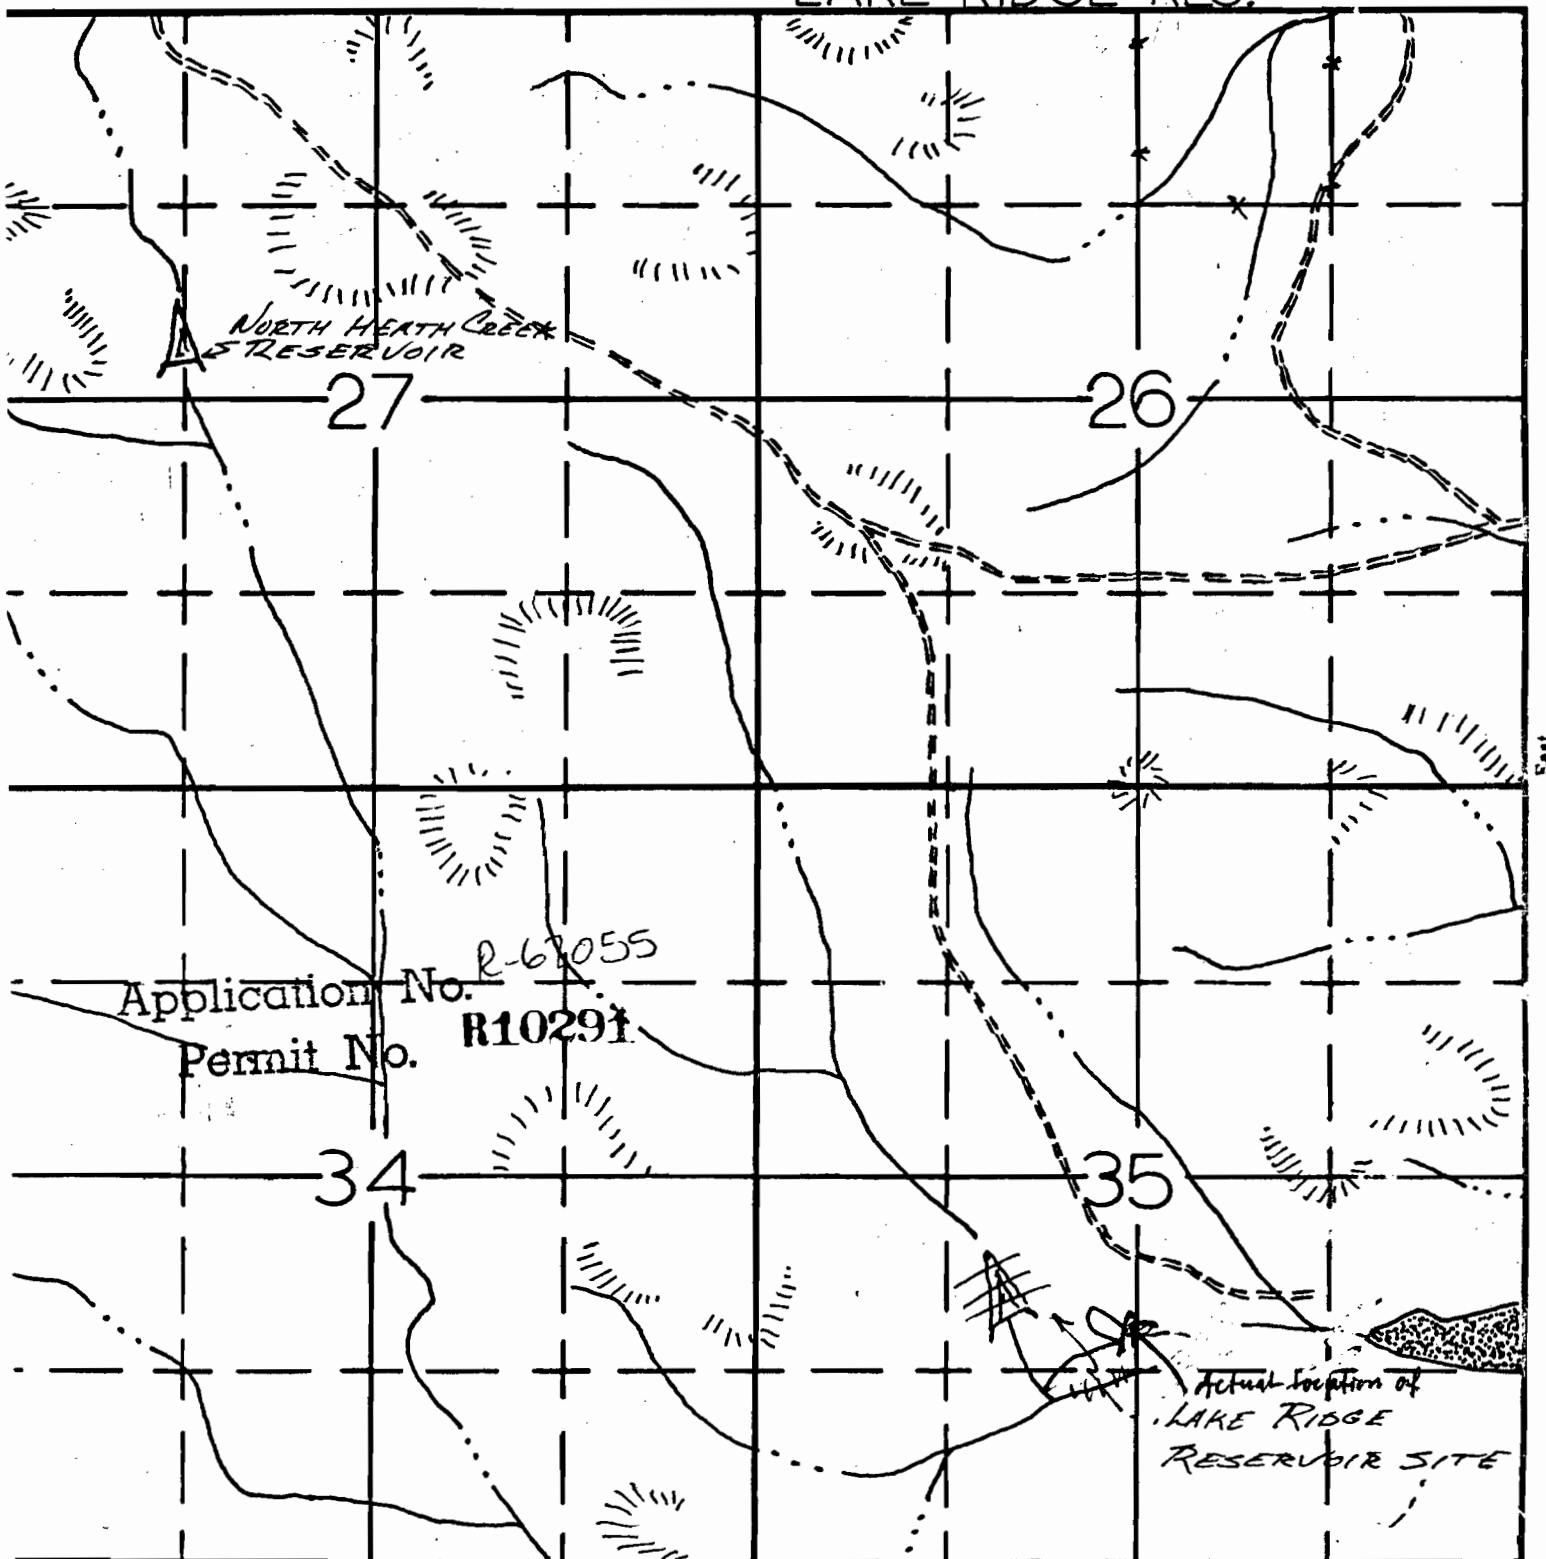

DRAWN - JA 1-83

South

APPLICATION No.