


UNITED STATES
DEPARTMENT OF THE INTERIOR
BUREAU OF LAND MANAGEMENT

SECTION
15 NENW

Oregon State Water Filings

TOWNSHIP 16 S, RANGE 45 E, W. M.

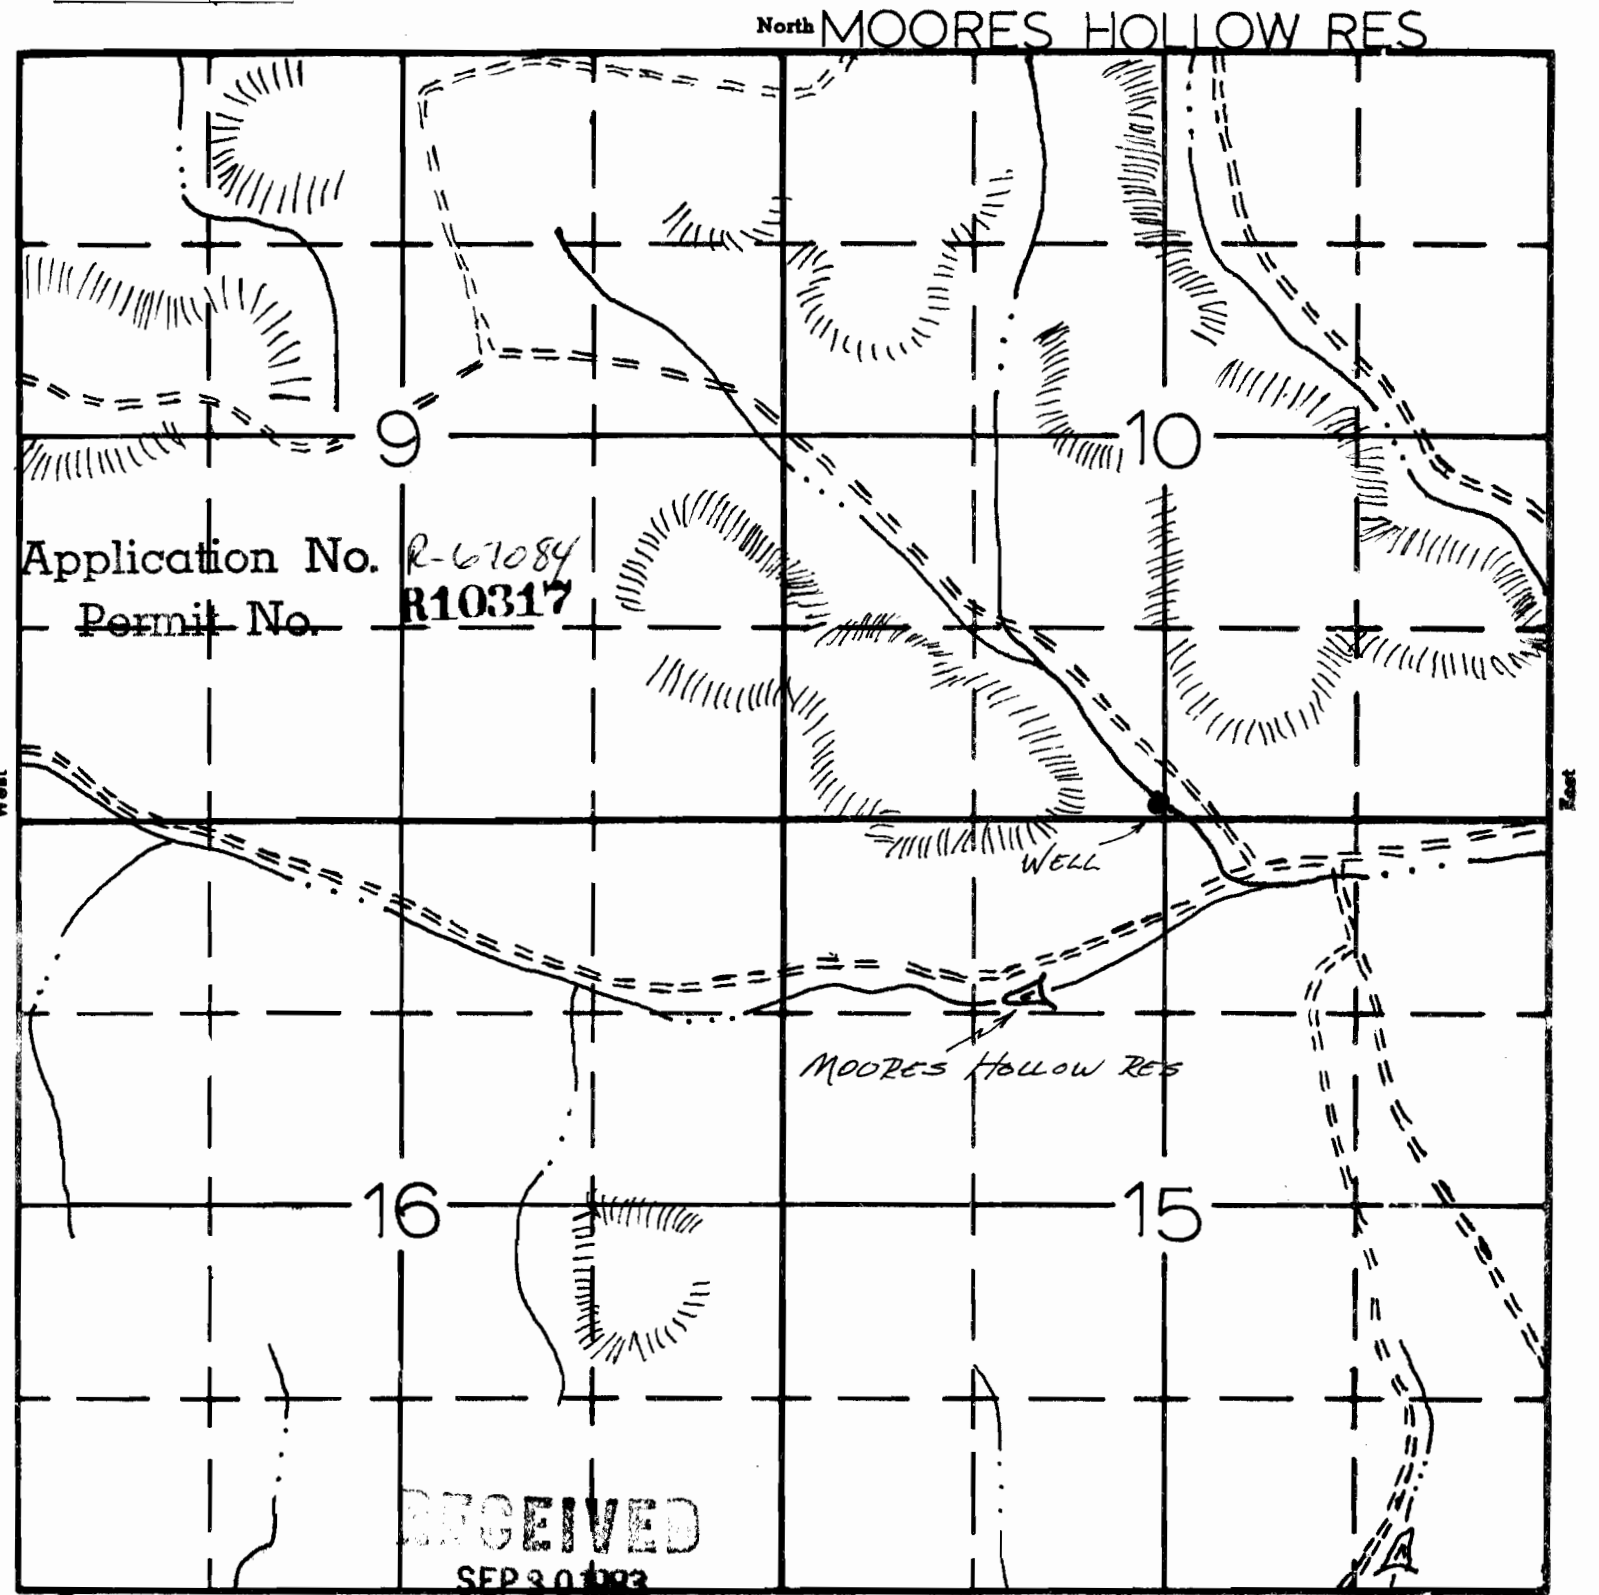

Application No. R-67084
Permit No. R10317

RECEIVED
SEP 30 1963

DRAWN JA 9/63

WATER RESOURCES DEPT.
SALEM, OREGON

APPLICATION No.
PERMIT No.