

Form A1-187
March 1961

UNITED STATES
DEPARTMENT OF THE INTERIOR
BUREAU OF LAND MANAGEMENT


SECTION

2 NWSE

Oregon State Water Filings

TOWNSHIP 27 S, RANGE 36 E, W. M.

North ROUND MOUNTAIN RES

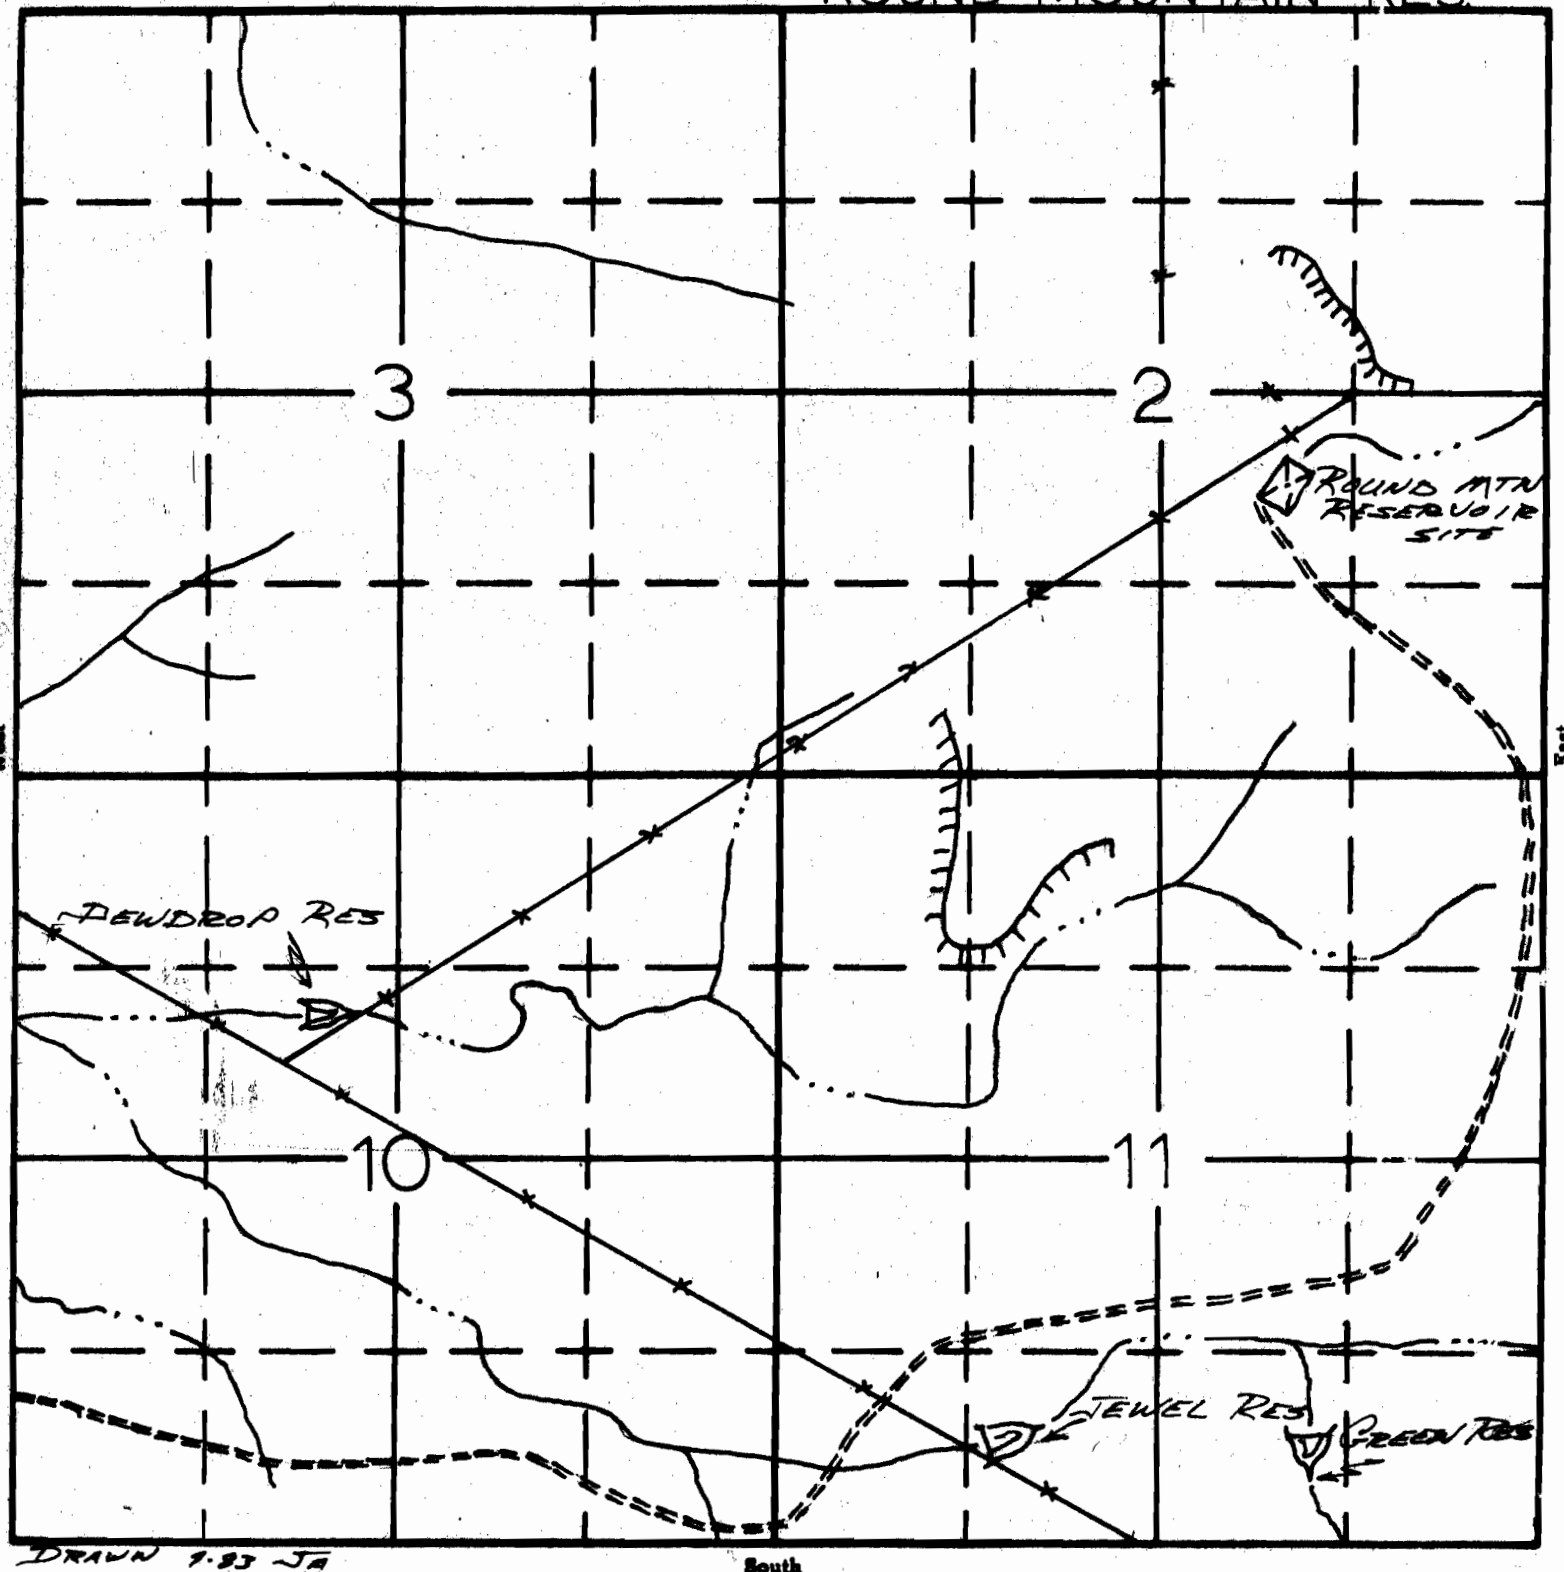

DRAWN 9-83 JA

South

APPLICATION No. P-67807
PERMIT No. R10632