

Form AI-187
March 1961

UNITED STATES
DEPARTMENT OF THE INTERIOR
BUREAU OF LAND MANAGEMENT

RECEIVED

MAR 17 1997


SECTION
26 NESW

Oregon State Water Filings

WATER RESOURCES DEPT.
SALEM, OREGON

TOWNSHIP 22 S, RANGE 37E, W. M.

WILLIAMS #4 PIT RES.

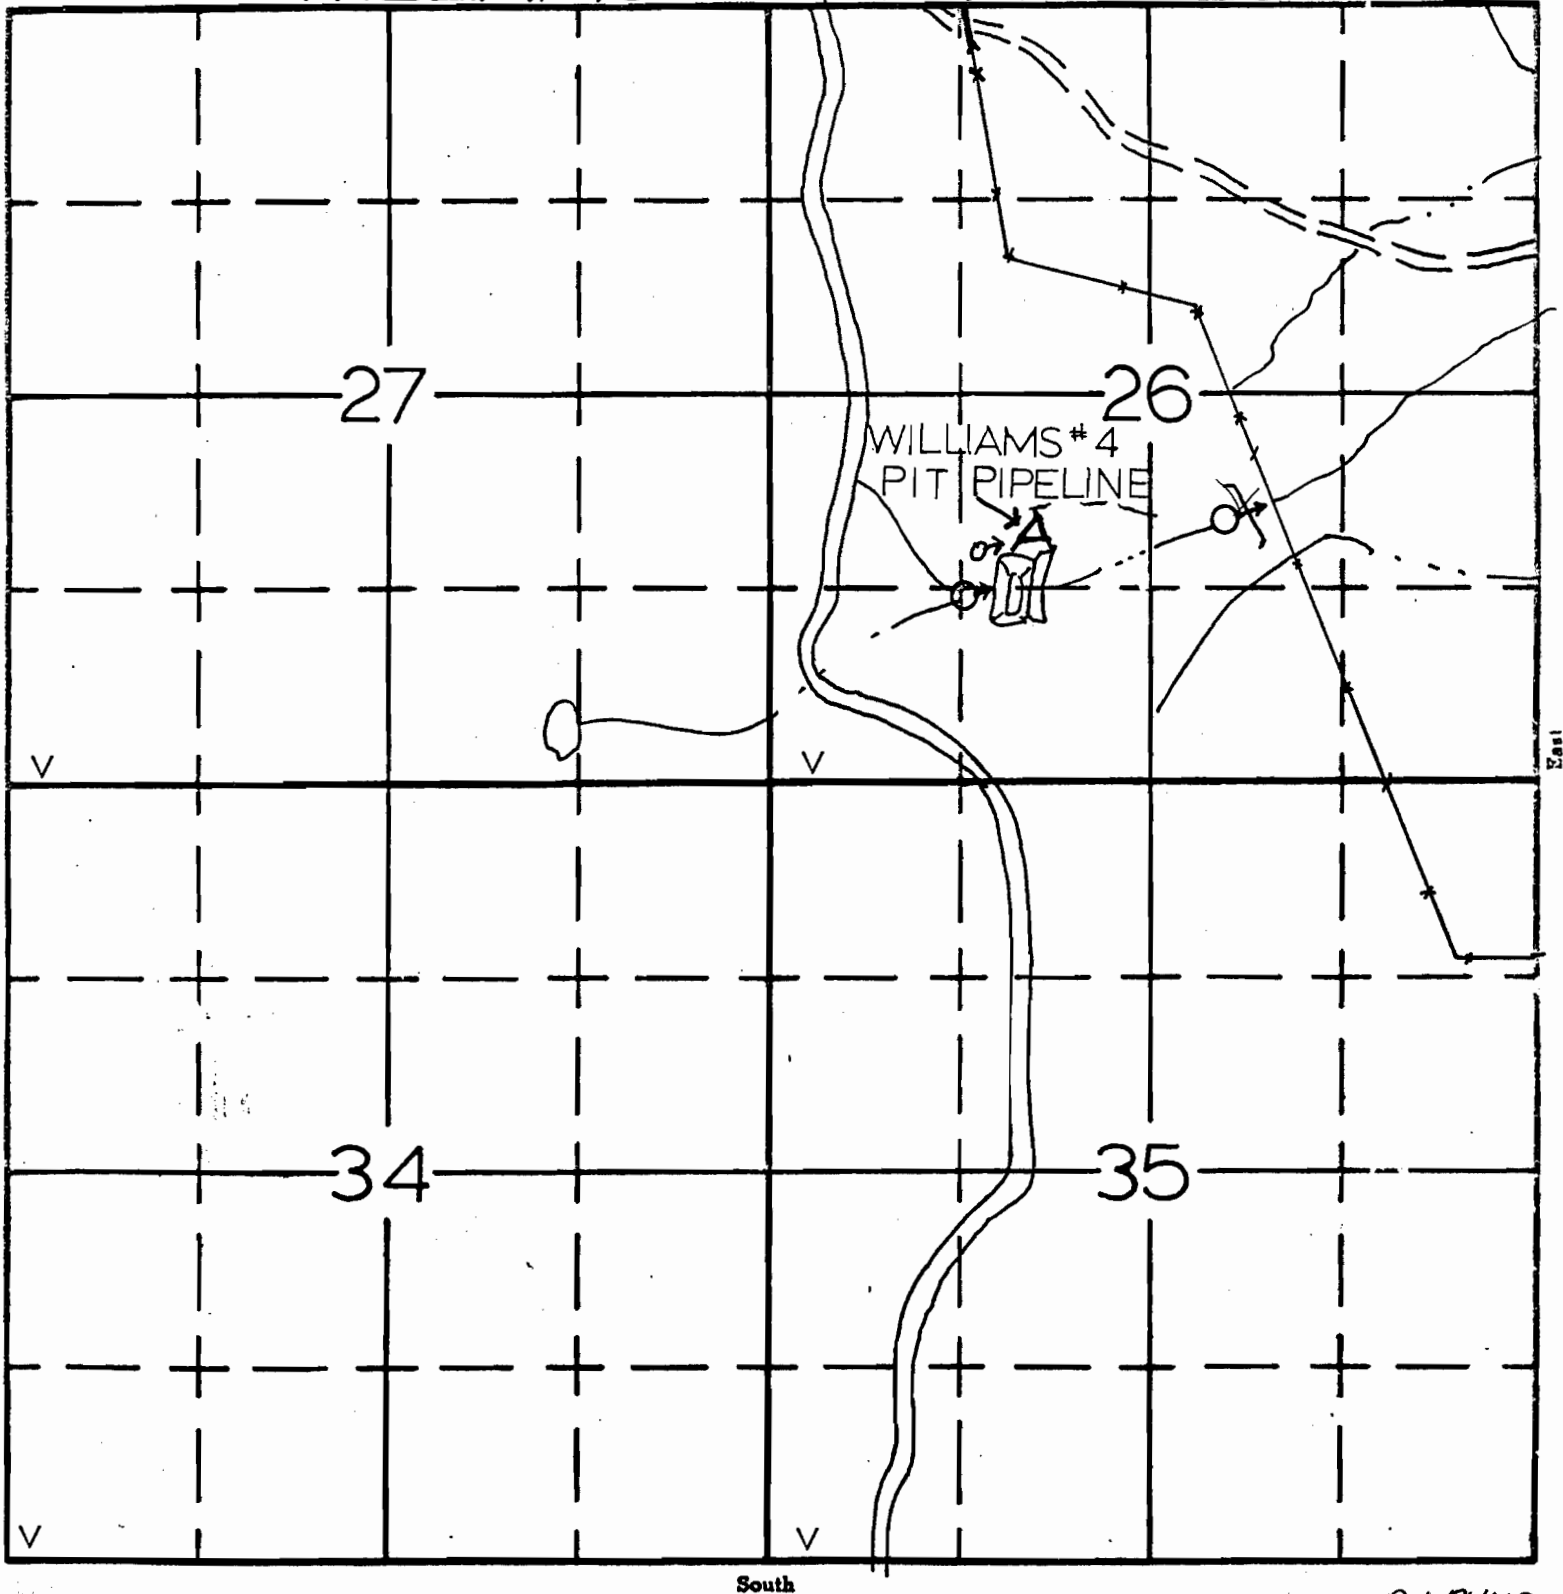

R-67849
APPLICATION No. **R1066**