



N  
↑  
N

CERTIFICATE No  
#47172 74262   
#46963 74258

BIC Revised 01 May 1993 HB3111

**MIDDLE FORK  
IRRIGATION DISTRICT**


PARKDALE OREGON




**SECTION 20 TIN RIOE**


SCALE: 1" = 400'

DWN. BY: REX    DATE: 30 DEC. 1988    SHEET \_\_\_ OF \_\_\_




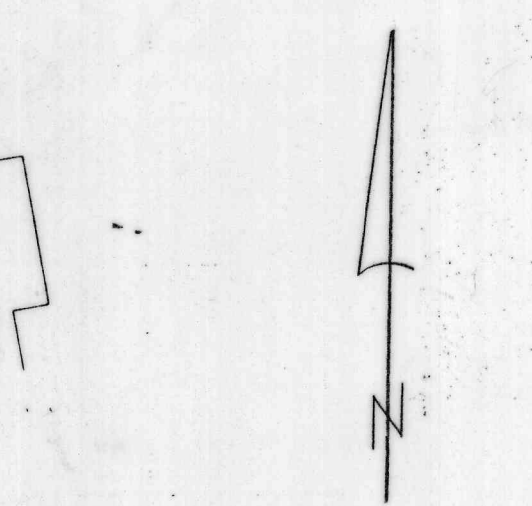

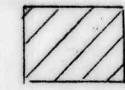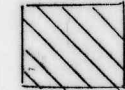CERTIFICATE No  
 # 20369 80478   
 # 46963 74258   
 14959 

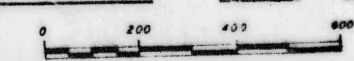D5H	Revised 16 August 1993	HB 3111
BTC	Revised 01 May 1992	HB 3111
<b>MIDDLE FORK IRRIGATION DISTRICT</b>		
PARKDALE		OREGON
<b>SECTION 5 TIS RIOE</b>		
		
DWN BY: REX	DATE: 27 JAN 1989	SHEET ___ OF ___



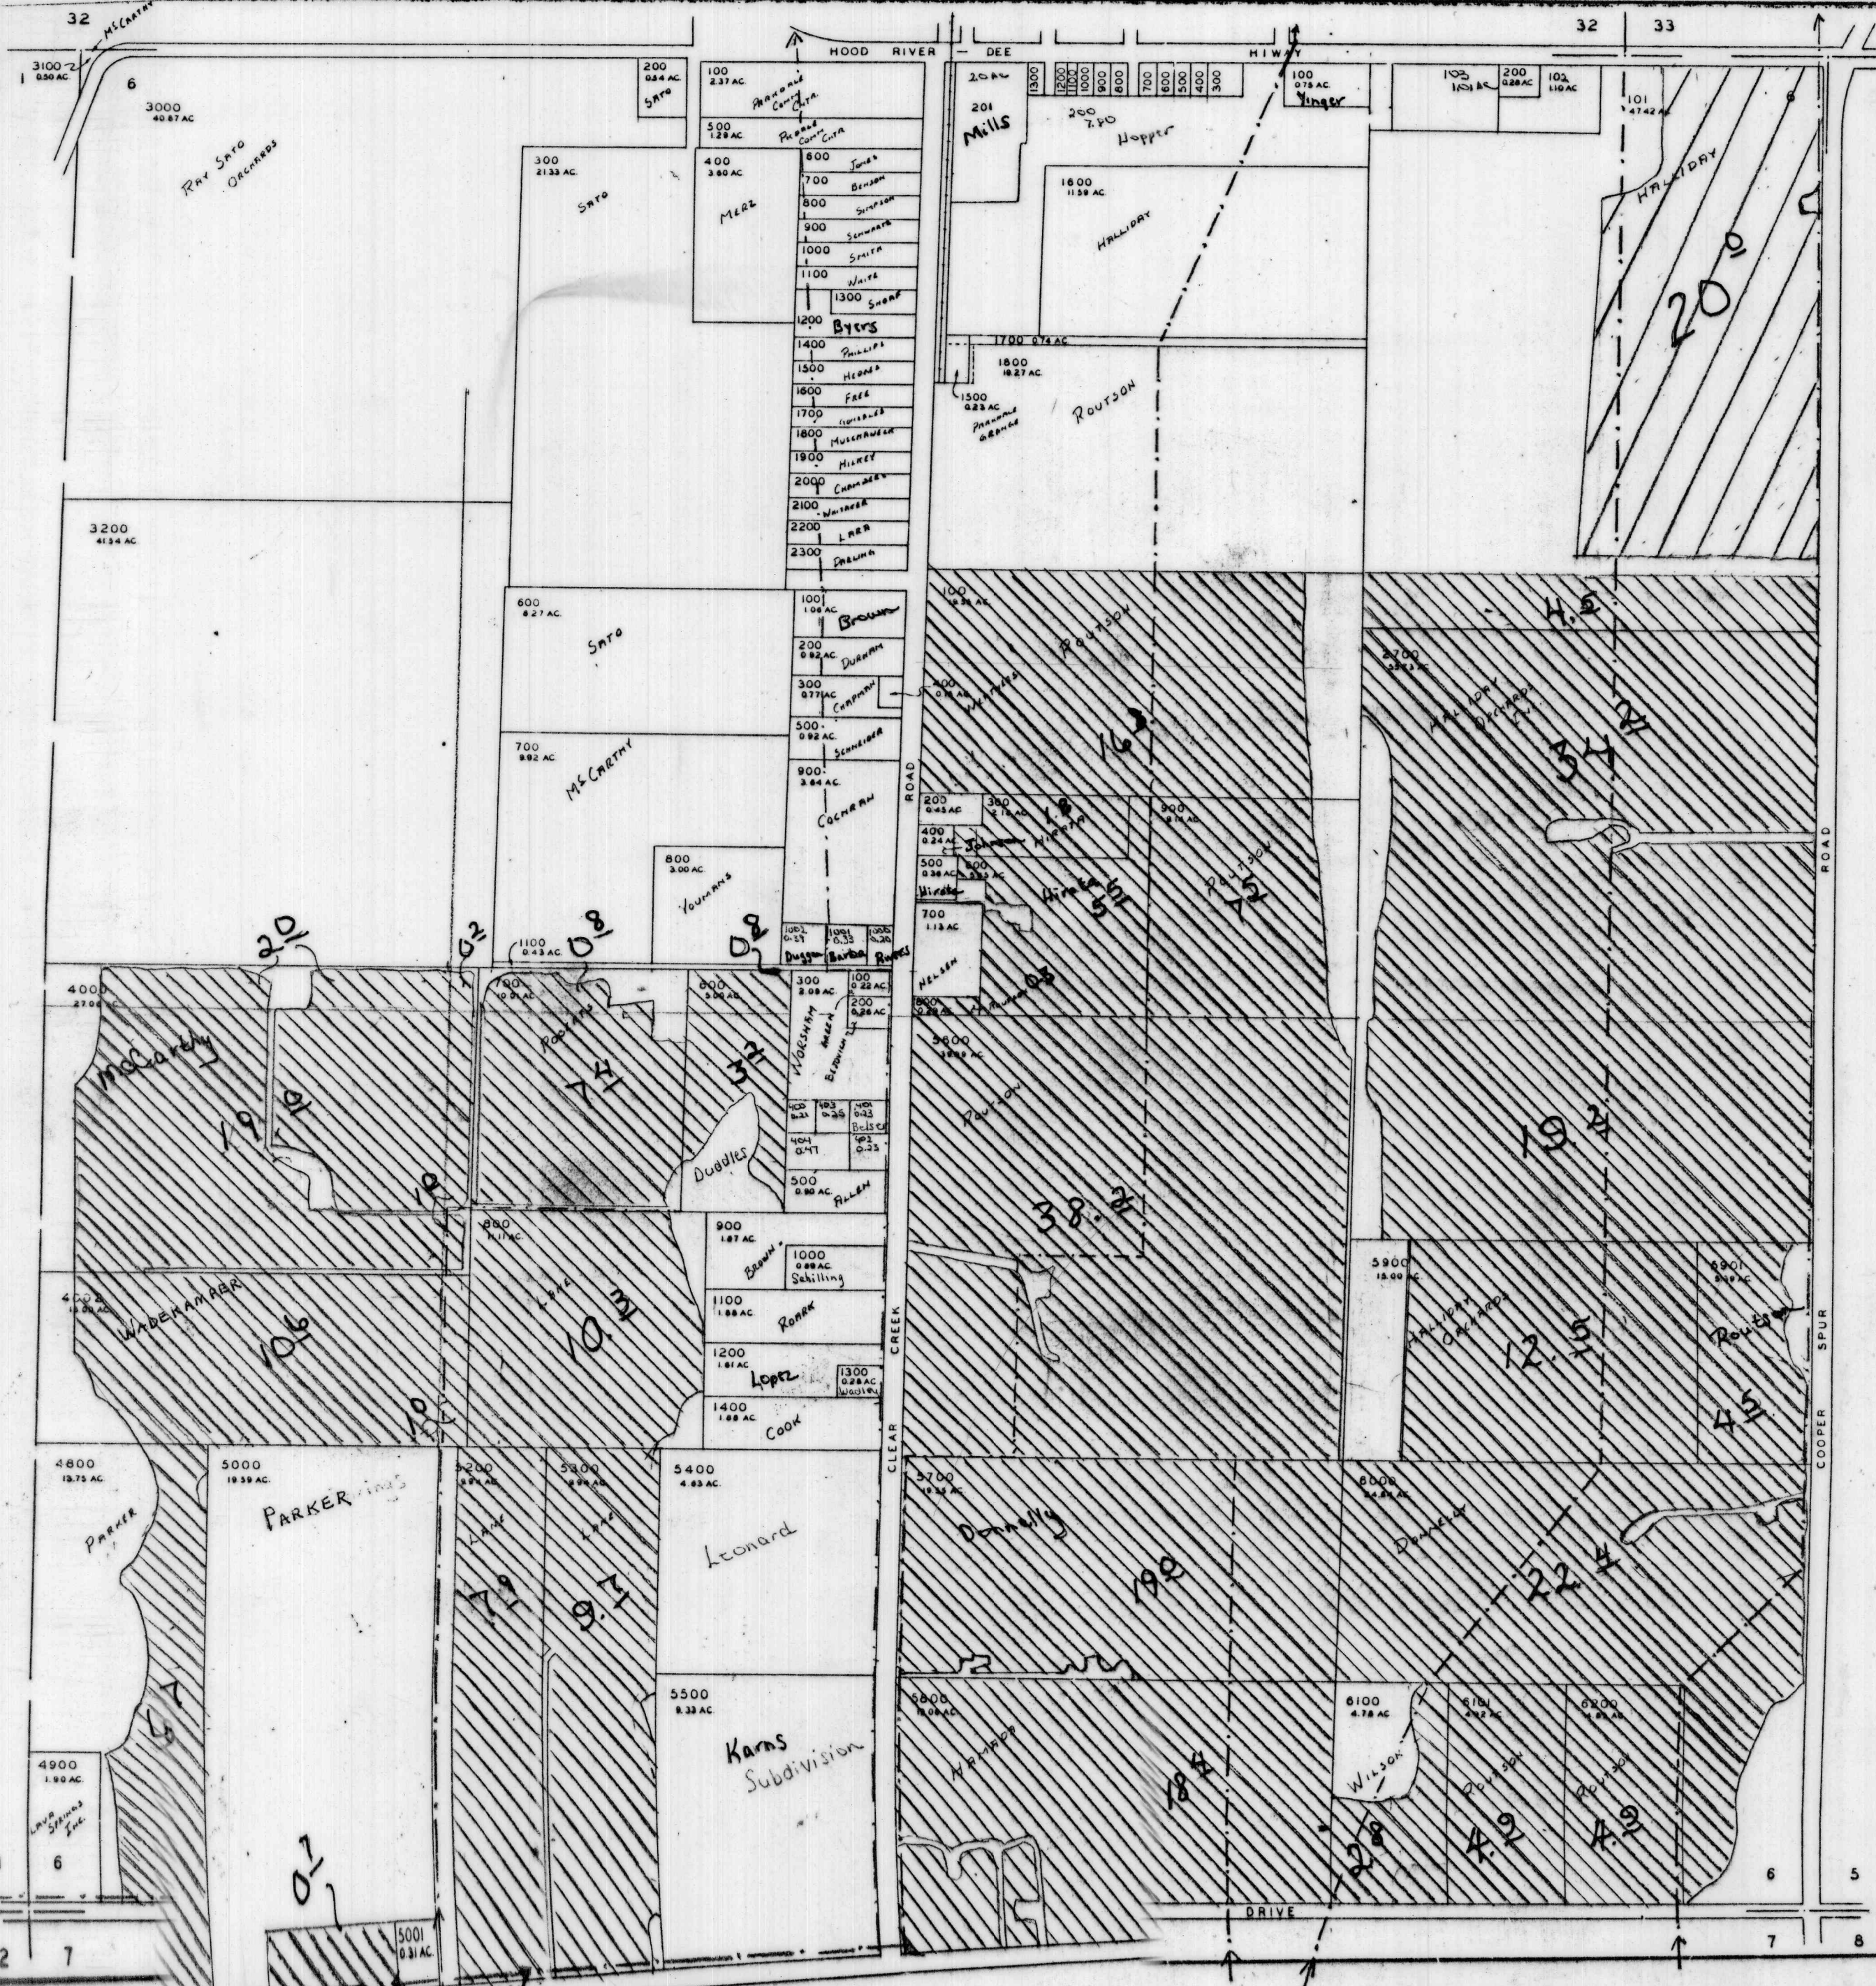

CERTIFICATE No

# 46960 74254

# 46963 74258

WMS Revised 01 August 1995 HB 3111  
 BJC Revised 01 May 1993 HB 3111

**MIDDLE FORK  
 IRRIGATION DISTRICT**


PARKDALE OREGON

**SECTION 6 TIS RIOE**

0 200 400 800

DWN. BY: REX DATE: 01 FEB. 1989 SHEET OF



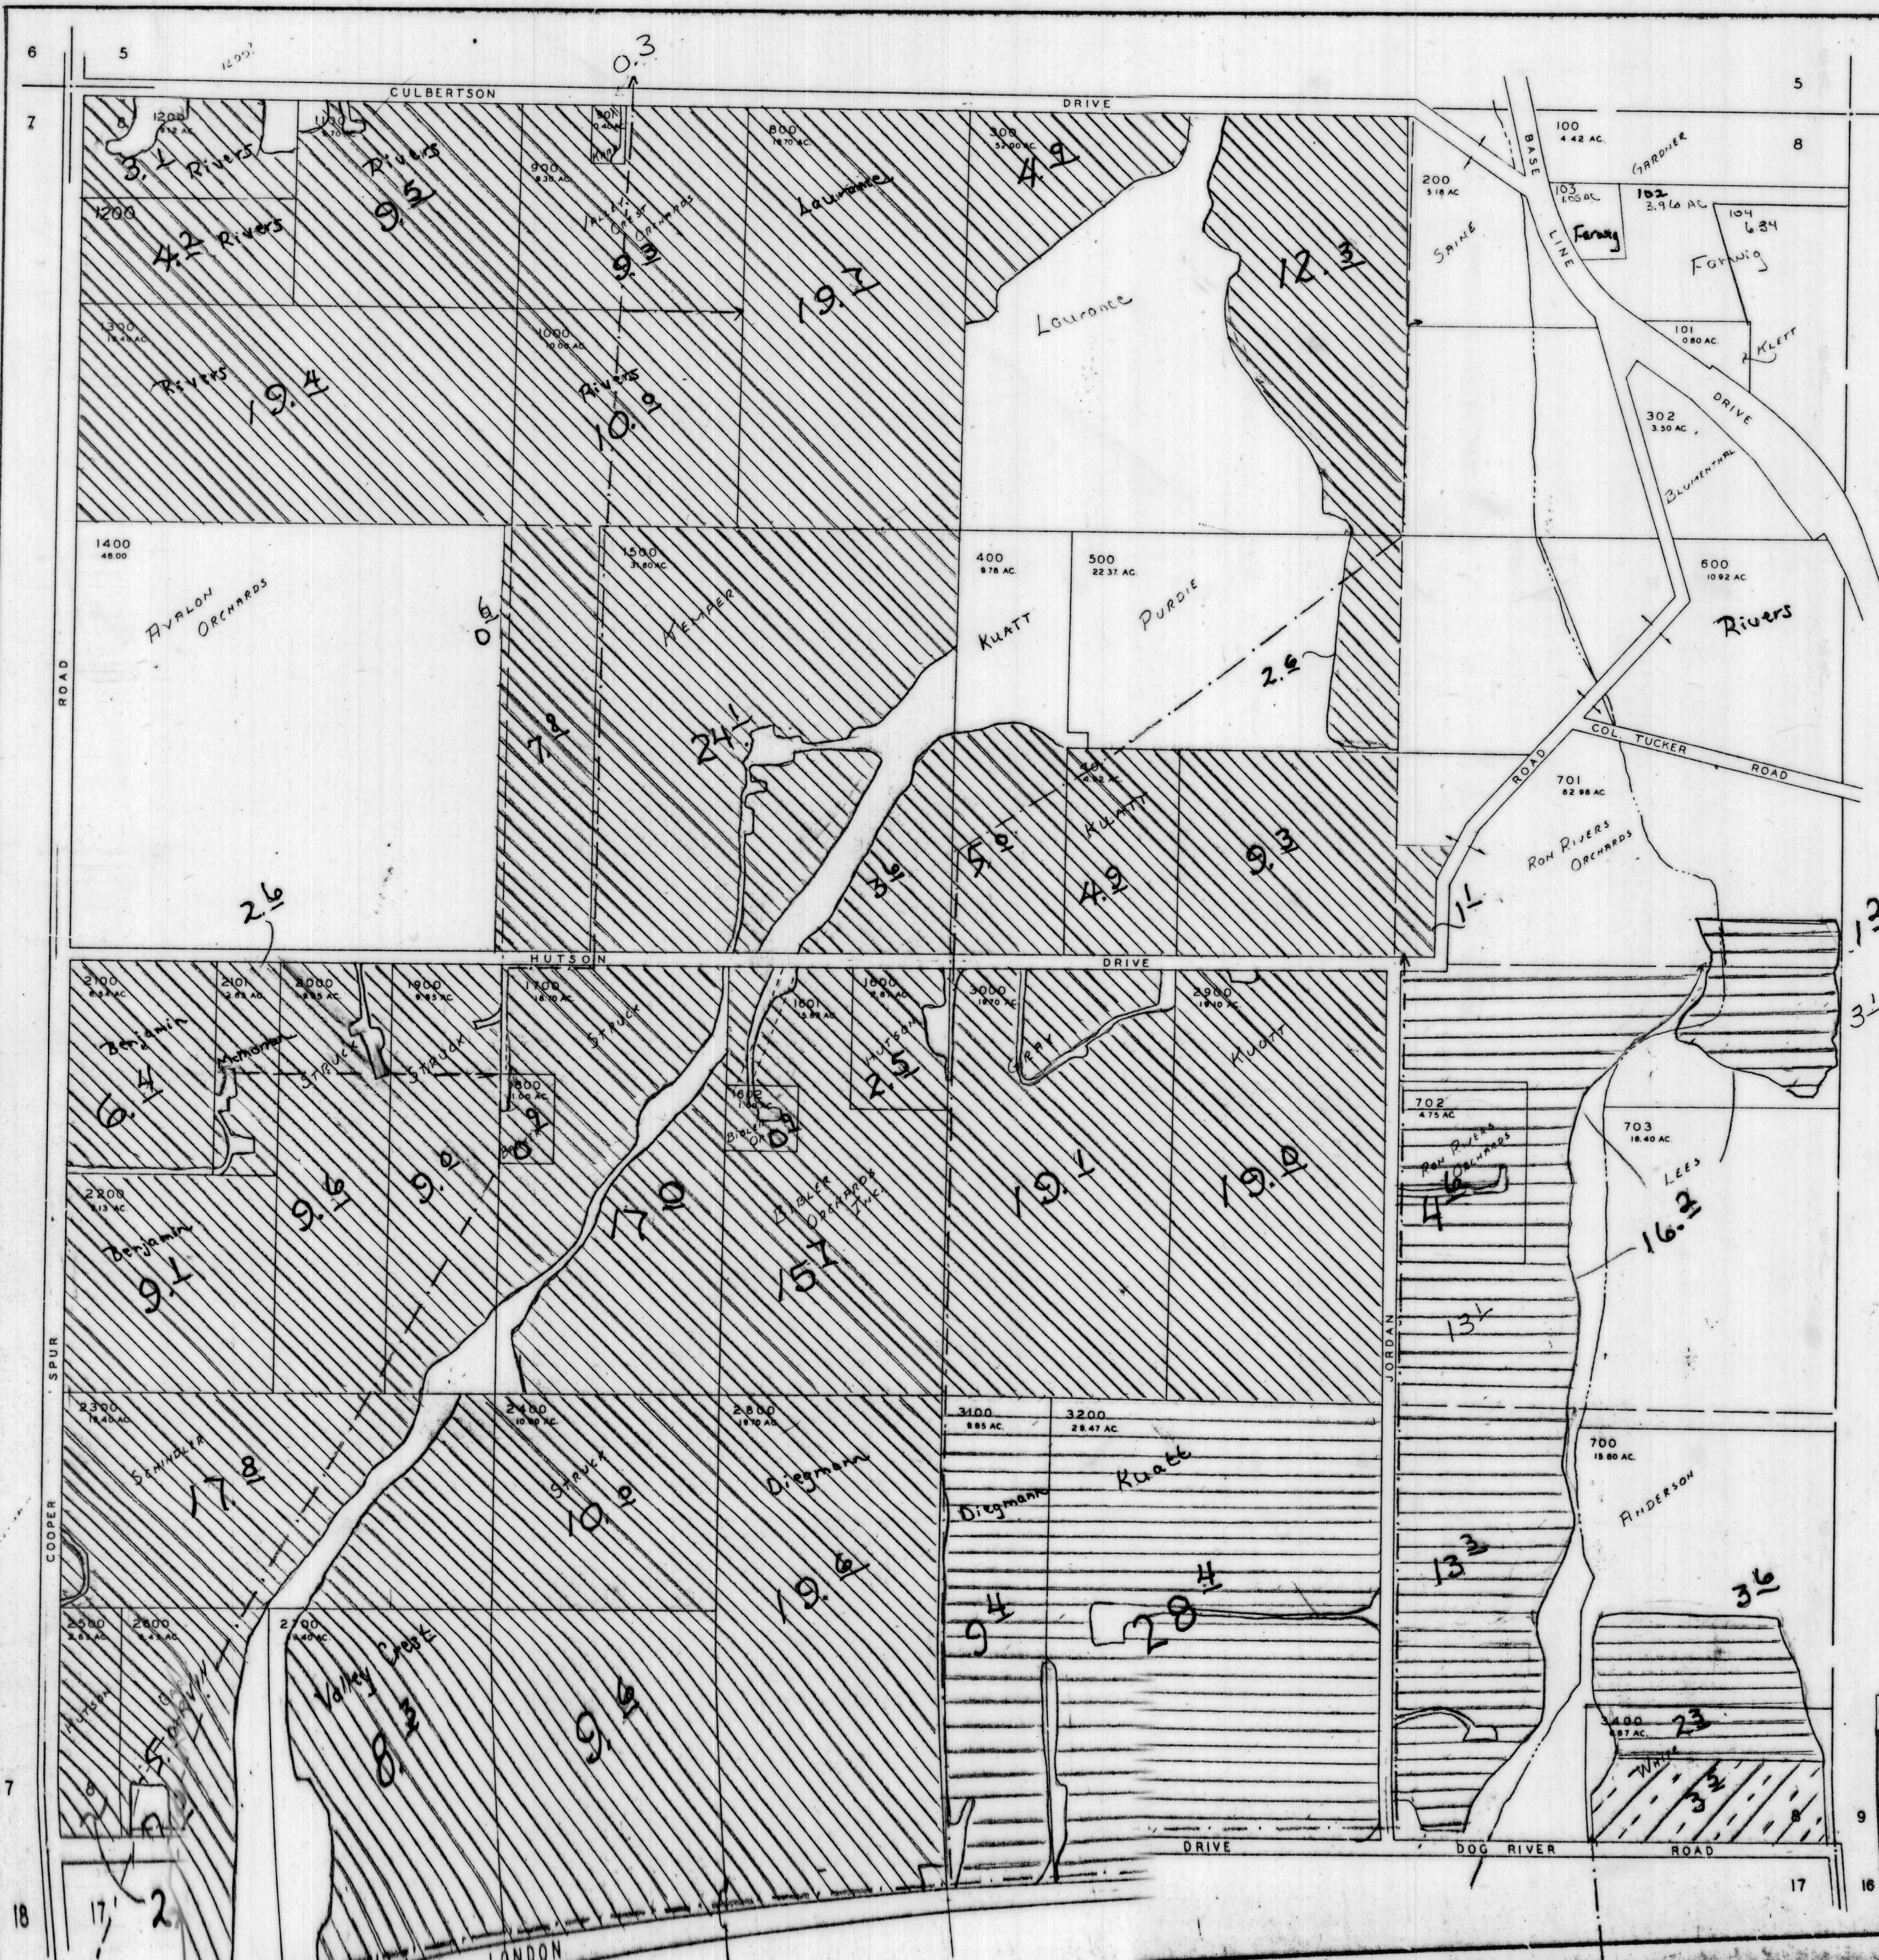

- CERTIFICATE No**
- 74258 #46963
  - 74255 #46961
  - 74264 #46265



WMS	Revised 01 Aug 1995	HB 3111
BSC	Revised 01 May 1993	HB 3111
<b>MIDDLE FORK IRRIGATION DISTRICT</b>		
PARKDALE		OREGON
<b>SECTION 8 T1S R10E</b>		
DWN. BY: REX	DATE: 15 FEB. 1989	SHEET OF