


CERTIFICATE No

- 74258 #46963
- 74255 #46961
- 74264 #46265




WMS	Revised 01 Aug 1995	HB 3111
ESC	Revised 01 May 1993	HB 3111
<b>MIDDLE FORK IRRIGATION DISTRICT</b>		
PARKDALE		OREGON
<b>SECTION 8 T1S R10E</b>		
DWN. BY: REX	DATE: 15 FEB. 1989	SHEET OF

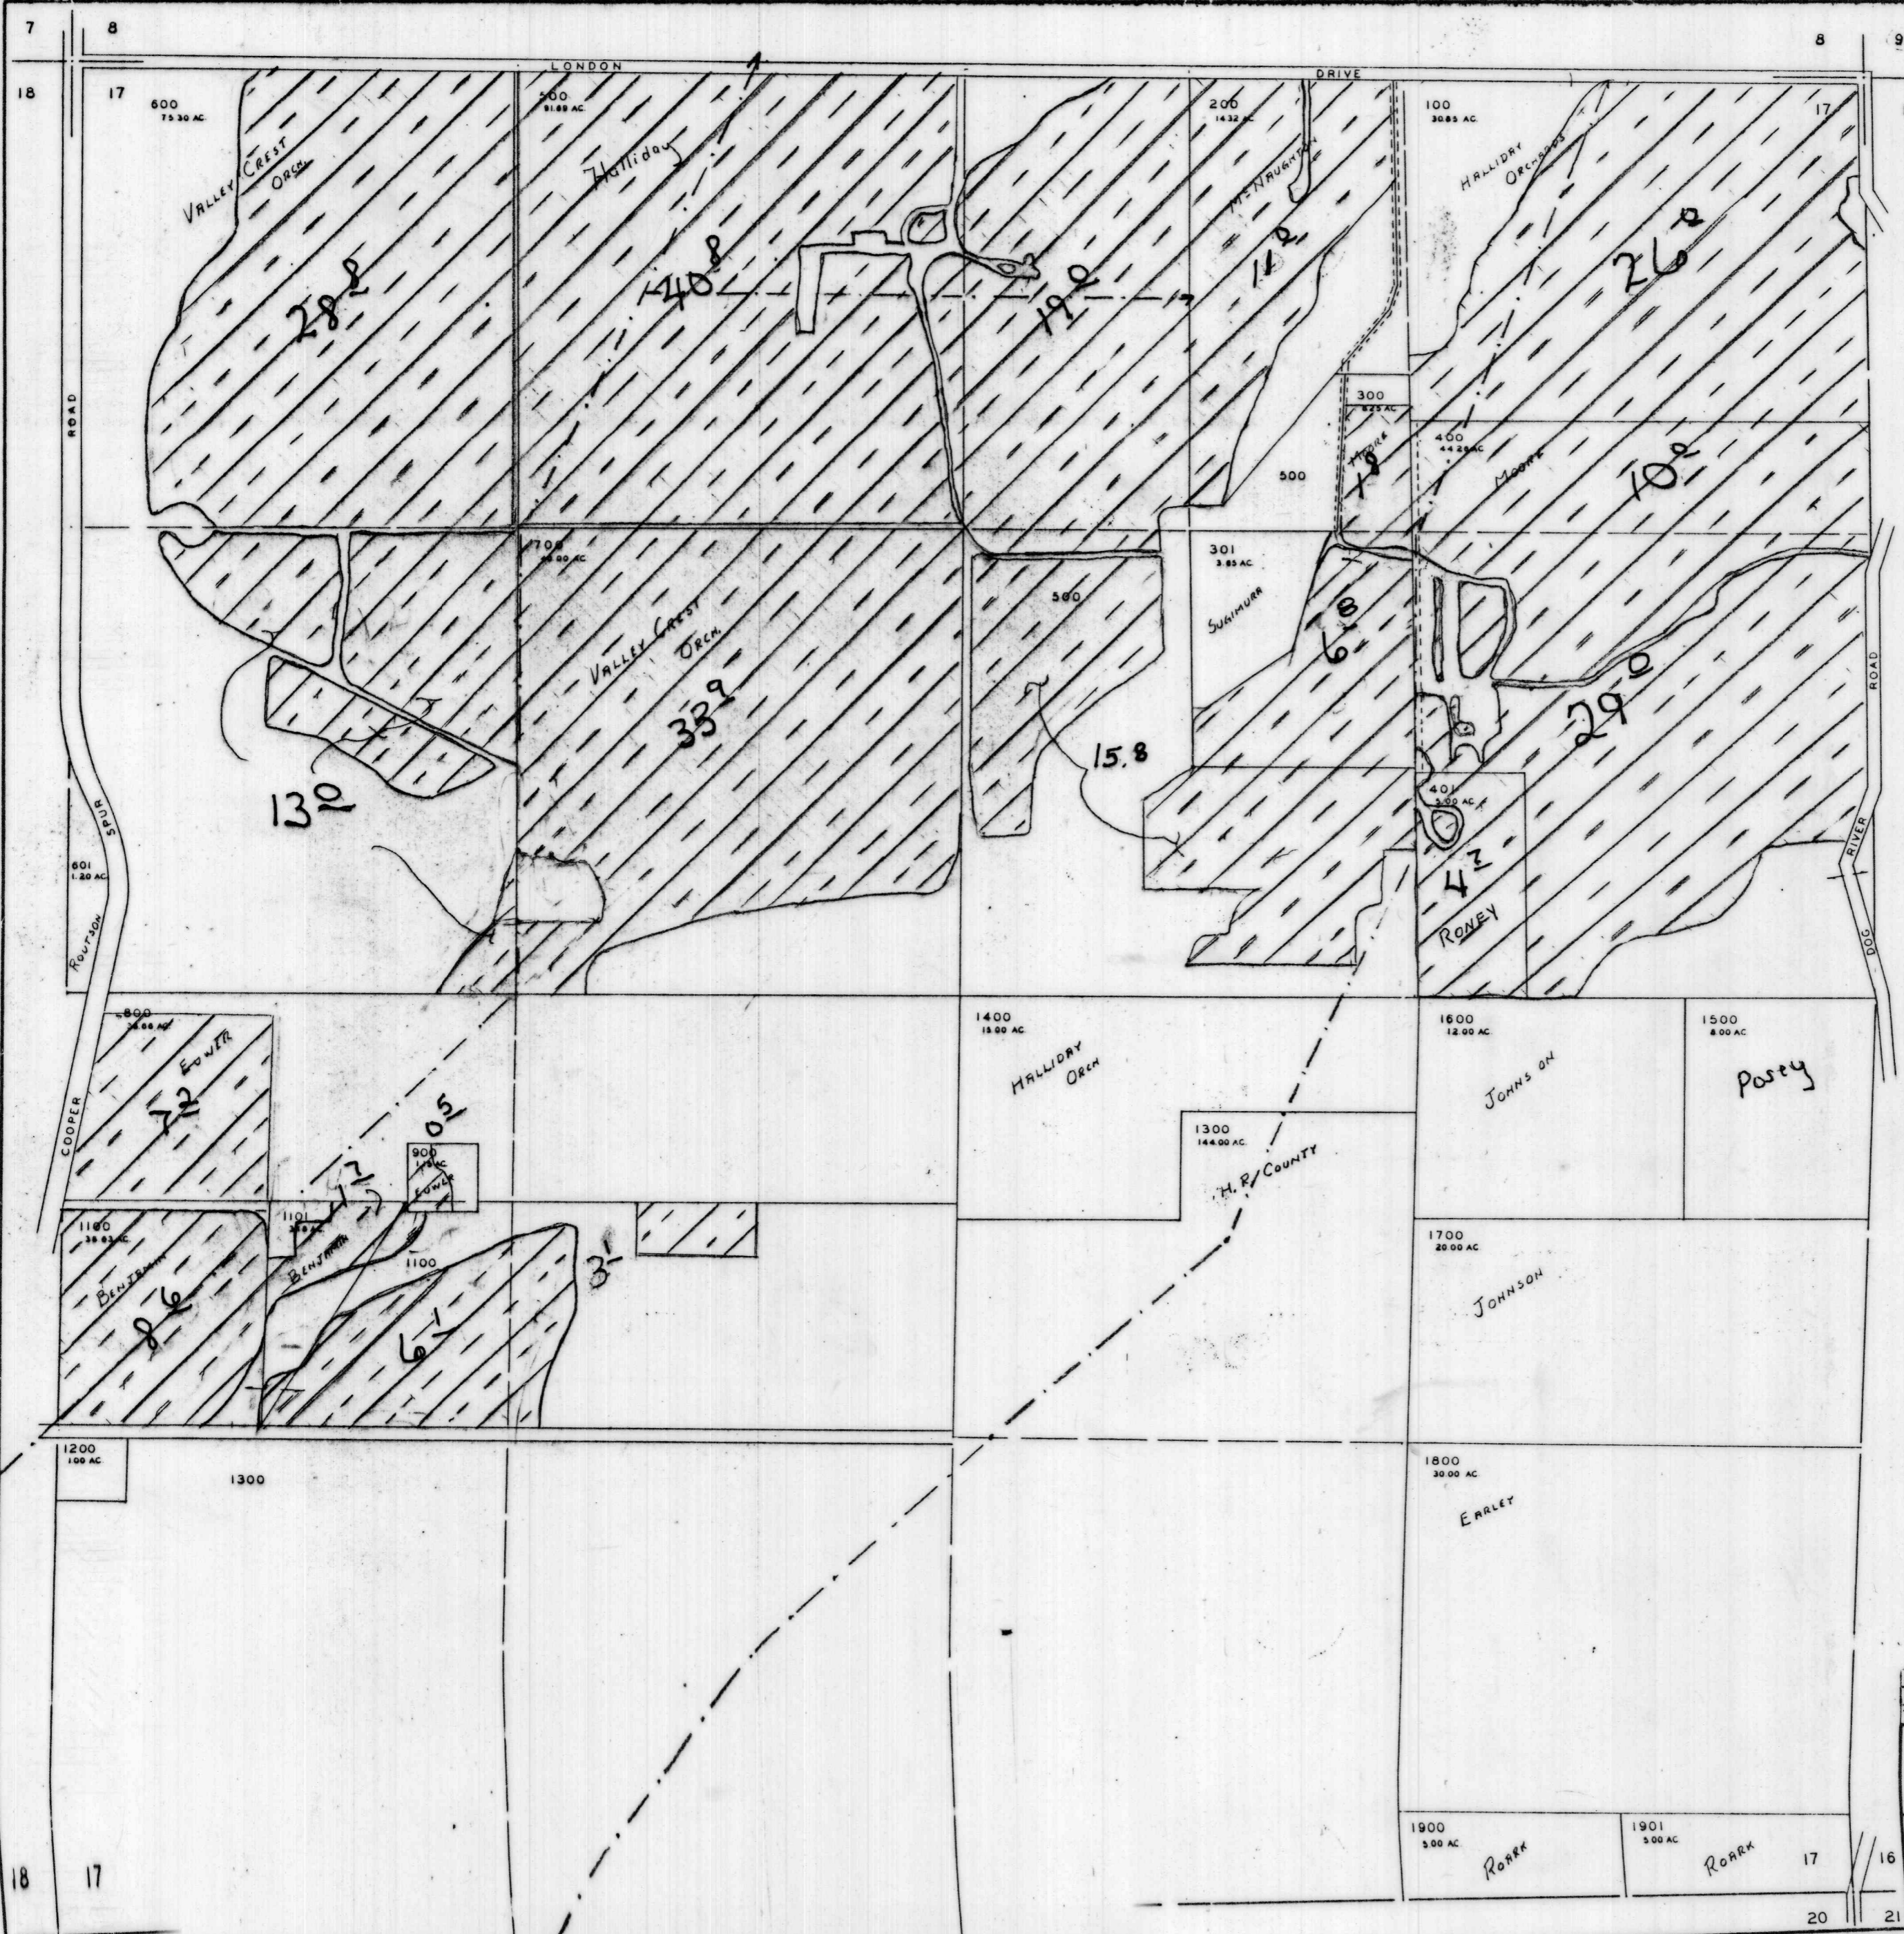



CERTIFICATE No  
 46265  
 74264

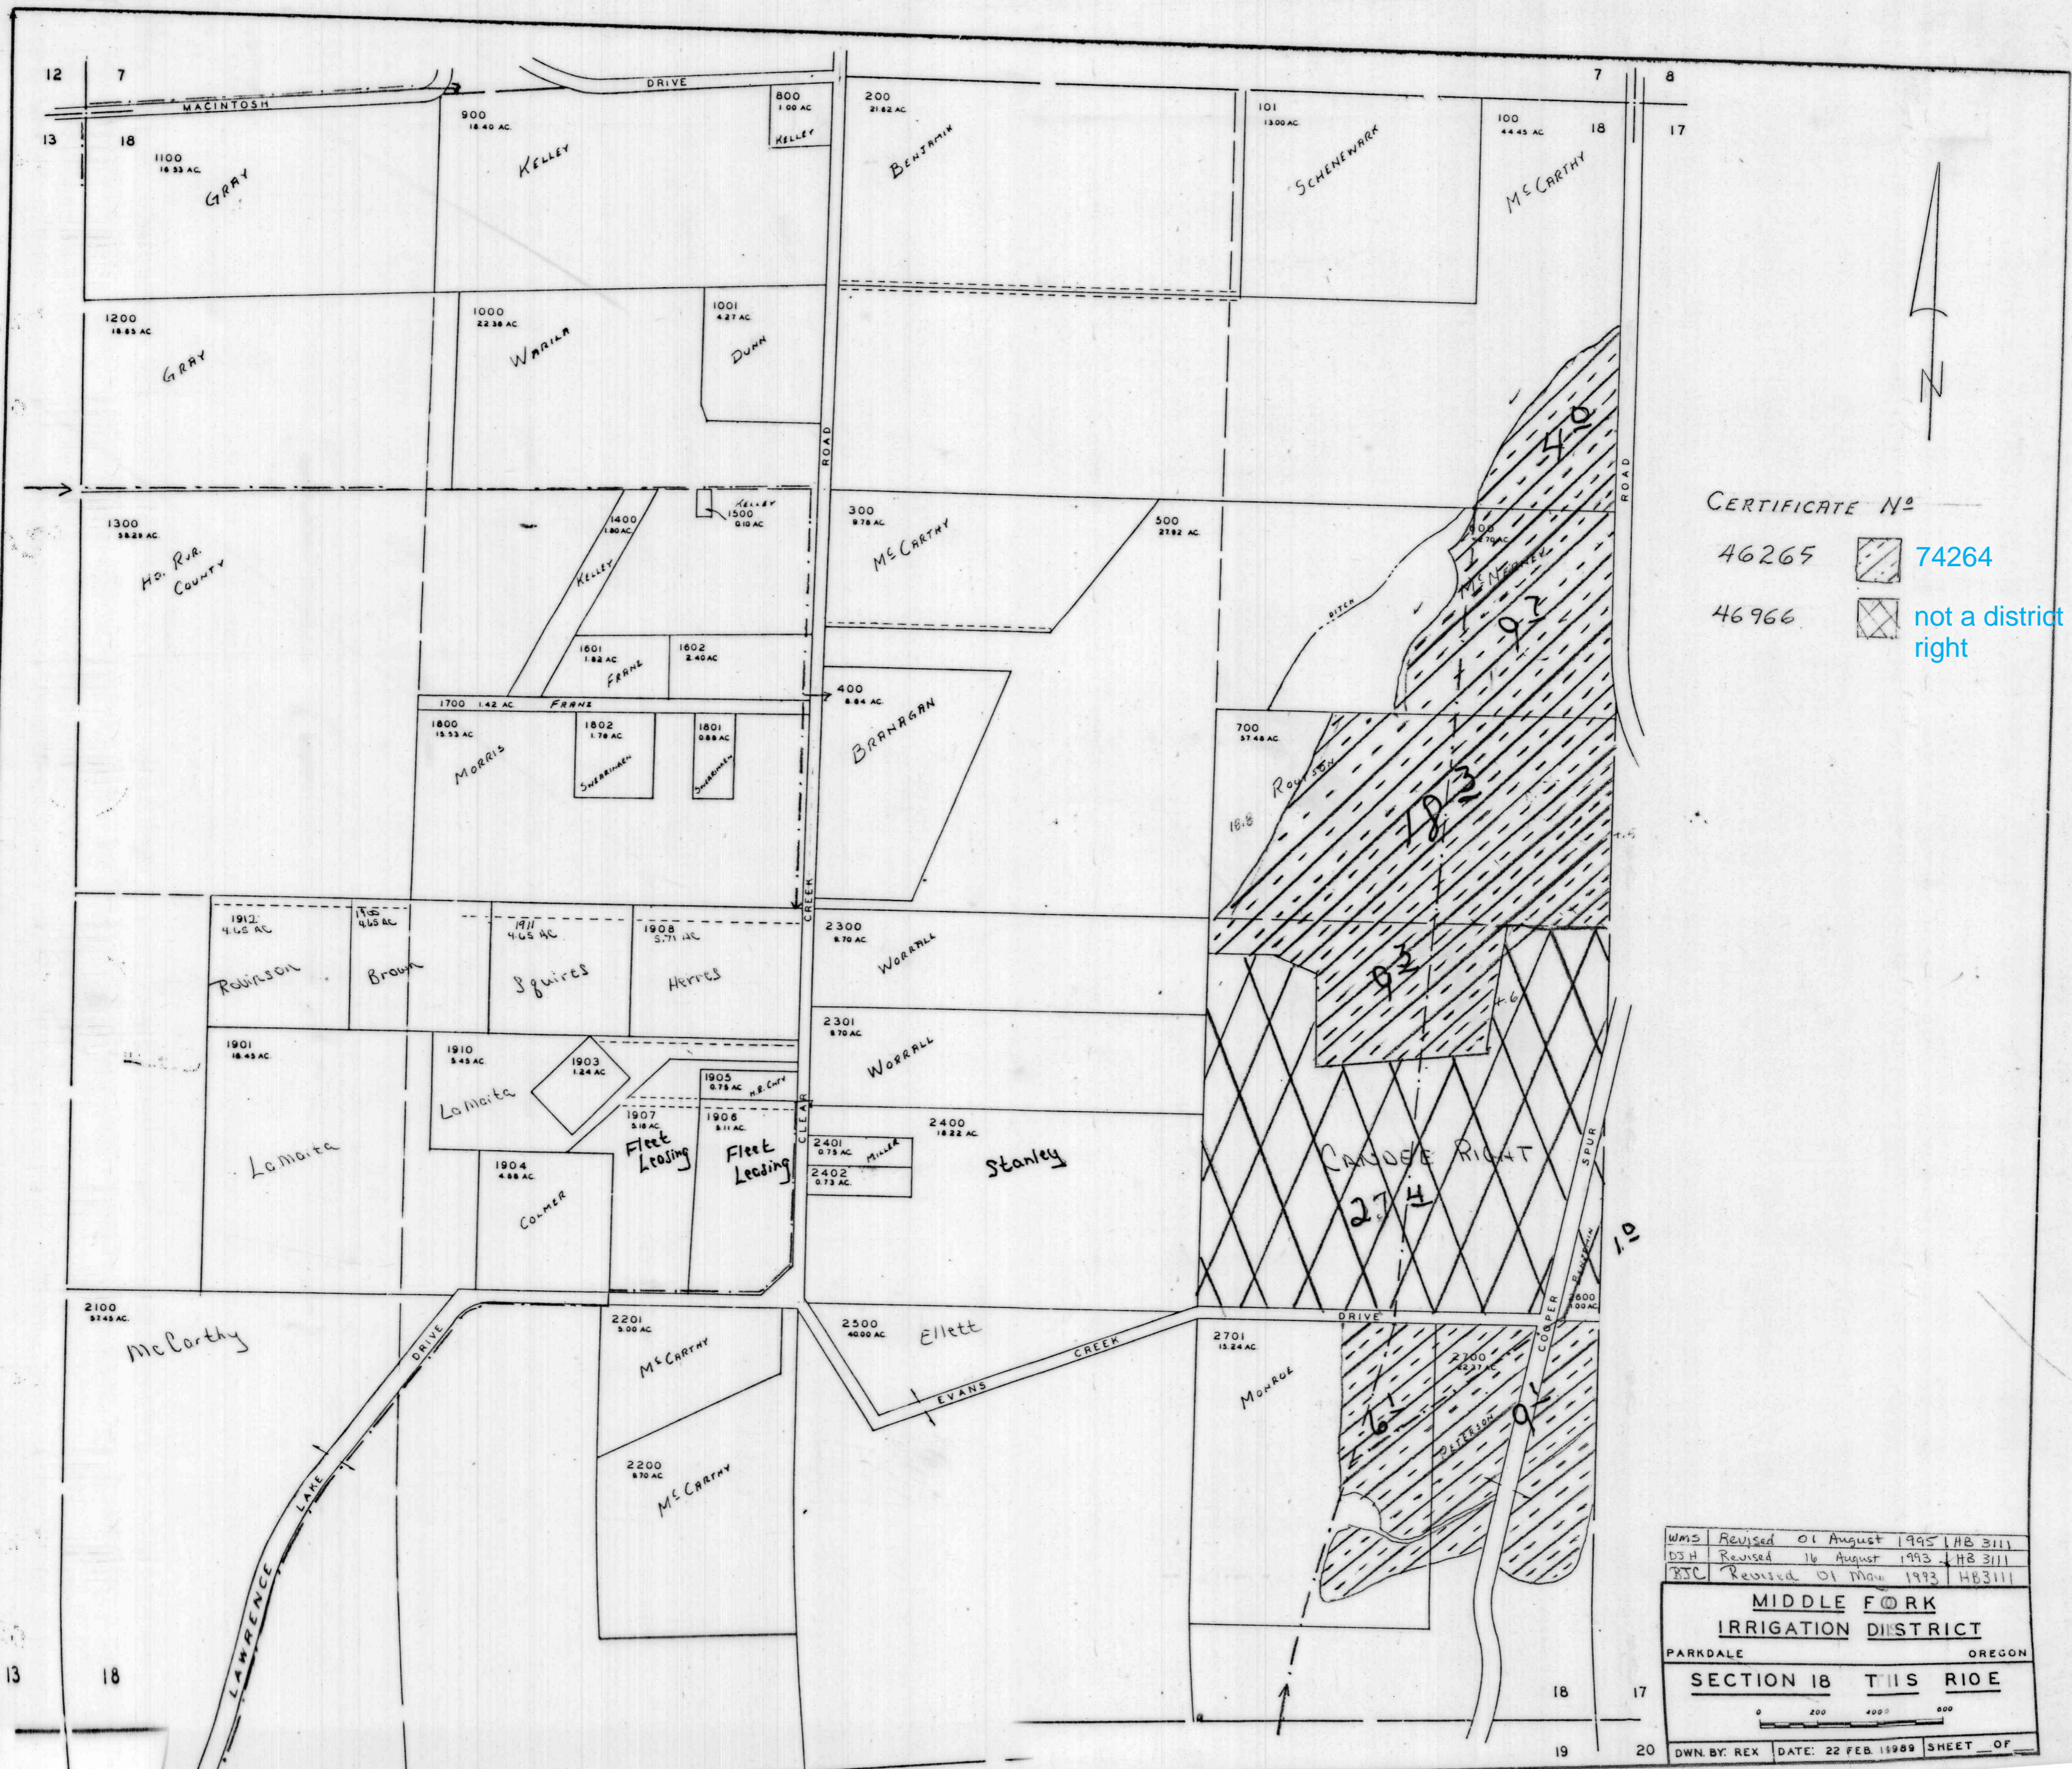
WMS	Revised	01 August 1995	HB 3111
DSH	Revised	16 August 1993	HB 3111
BSC	Revised	01 March 1993	4B 3111
<b>MIDDLE FORK IRRIGATION DISTRICT</b>			
PARKDALE		OREGON	
<b>SECTION 17</b>		<b>TIS RICE</b>	
DWN. BY: REX		DATE: 21 FEB. 1989	SHEET OF






CERTIFICATE N<sup>o</sup>


46265  74264


46966  not a district right

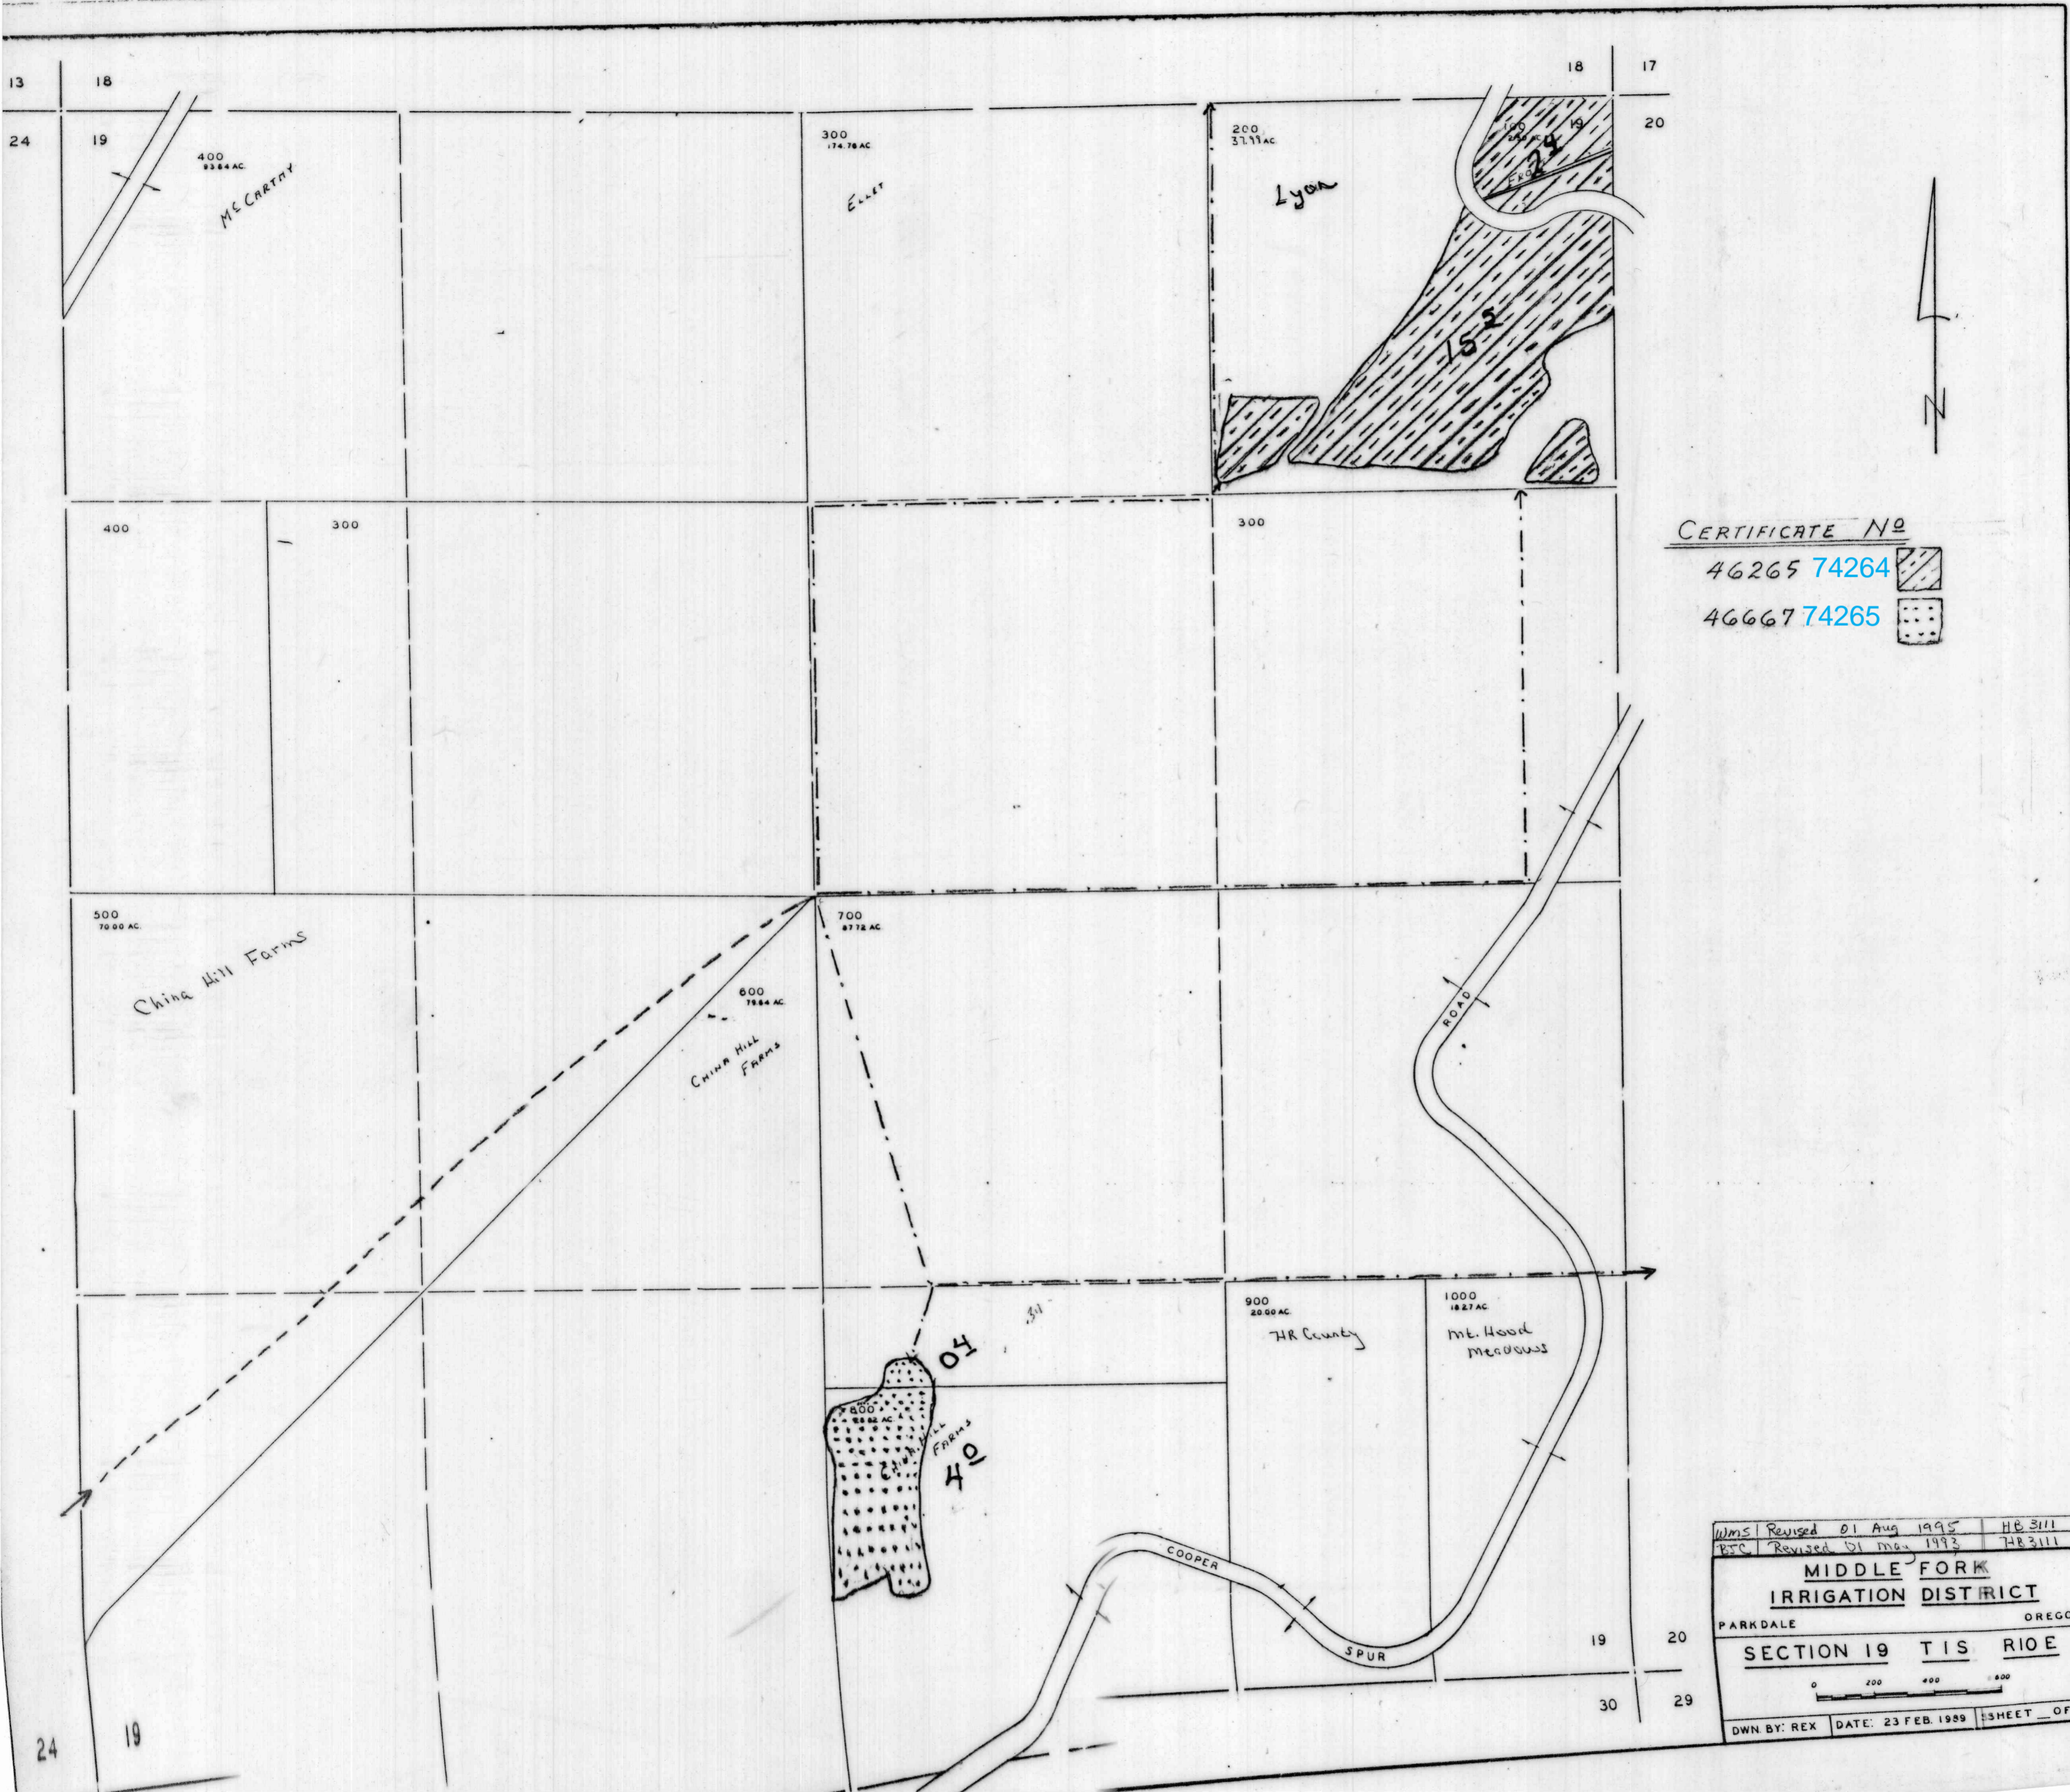WMS	Revised	01 August 1995	HB 3111
D3H	Revised	16 August 1993	HB 3111
BSC	Revised	01 May 1993	HB 3111
<b>MIDDLE FORK</b>			
<b>IRRIGATION DISTRICT</b>			
PARKDALE		OREGON	
<b>SECTION 18 THIS R10E</b>			
			
DWN. BY: REX	DATE: 22 FEB. 1989	SHEET OF	



CERTIFICATE No  
 46265 74264   
 46667 74265 

WMS	Revised 01 Aug 1995	HB 3111
BSC	Revised 01 May 1993	HR 3111
<b>MIDDLE FORK</b>		
<b>IRRIGATION DISTRICT</b>		
PARKDALE	OREGON	
<b>SECTION 19 TIS RIOE</b>		
		
DWN BY: REX	DATE: 23 FEB. 1999	SHEET ___ OF ___

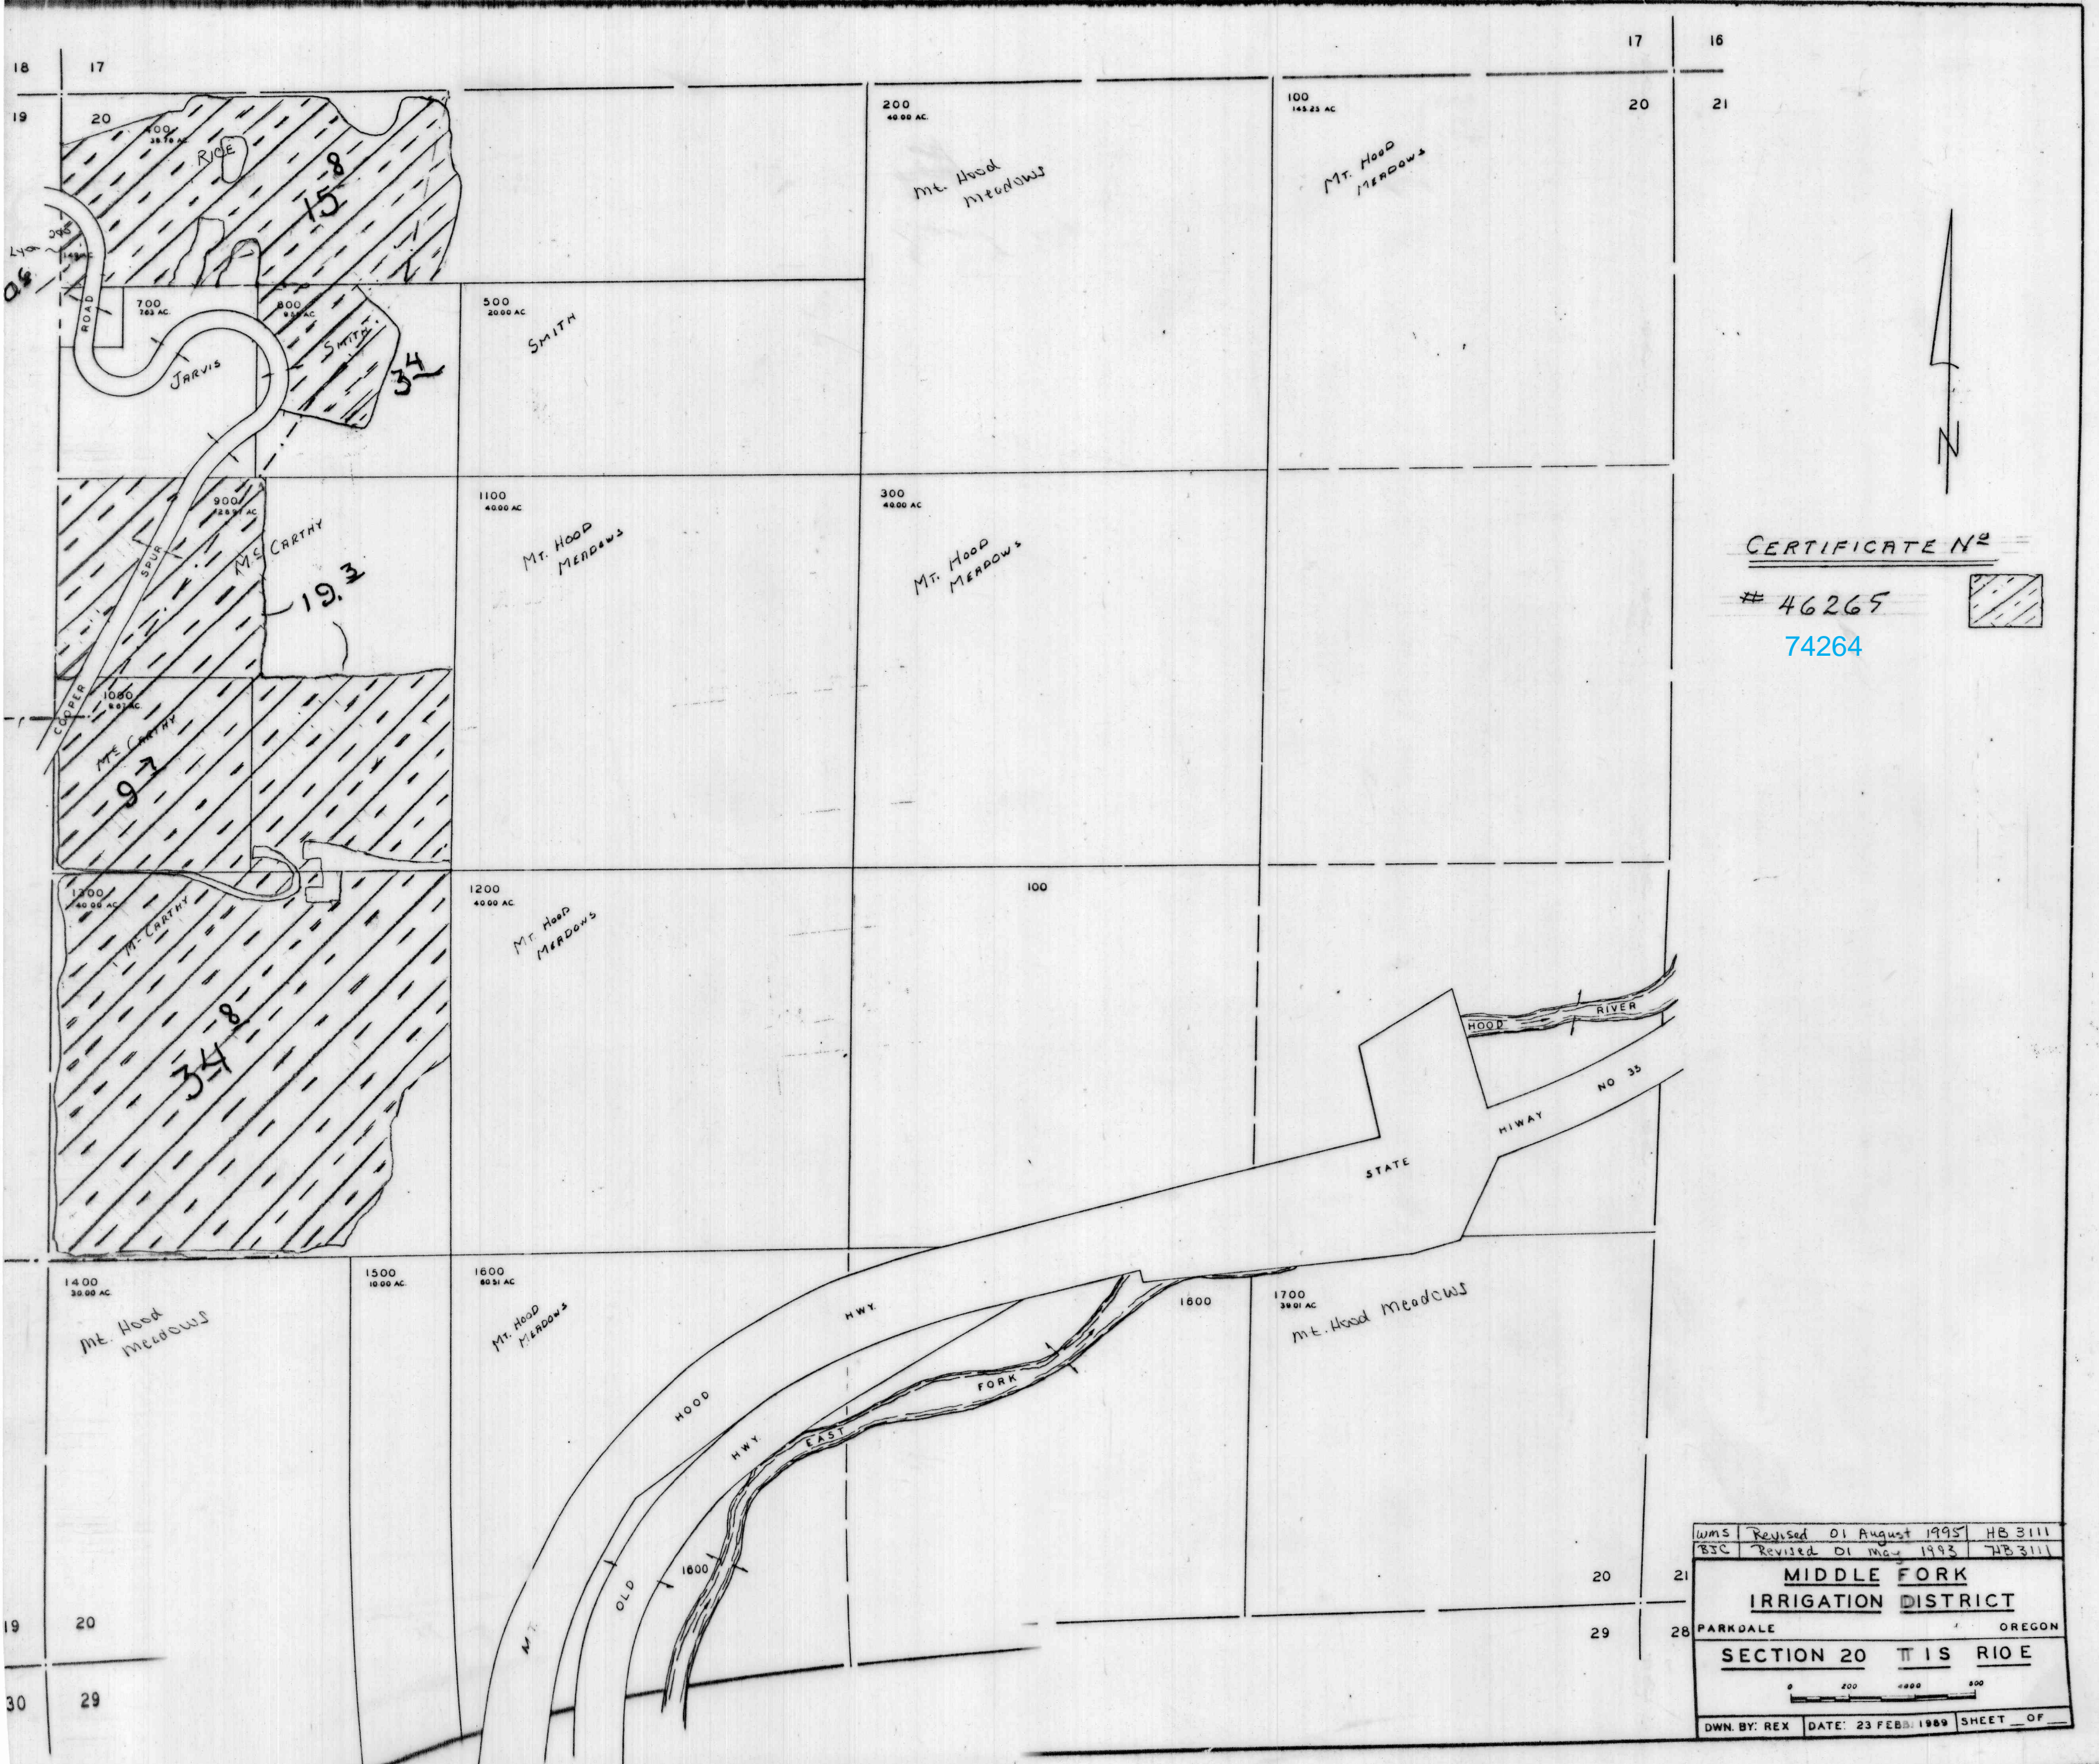

CERTIFICATE N<sup>o</sup>  
 # 46265  
 74264



WMS	Revised 01 August 1995	HB 3111
BSC	Revised 01 May 1993	7B 3111
<b>MIDDLE FORK IRRIGATION DISTRICT</b>		
PARKDALE		OREGON
<b>SECTION 20 T1S R1E</b>		
DWN. BY: REX	DATE: 23 FEB. 1989	SHEET OF