
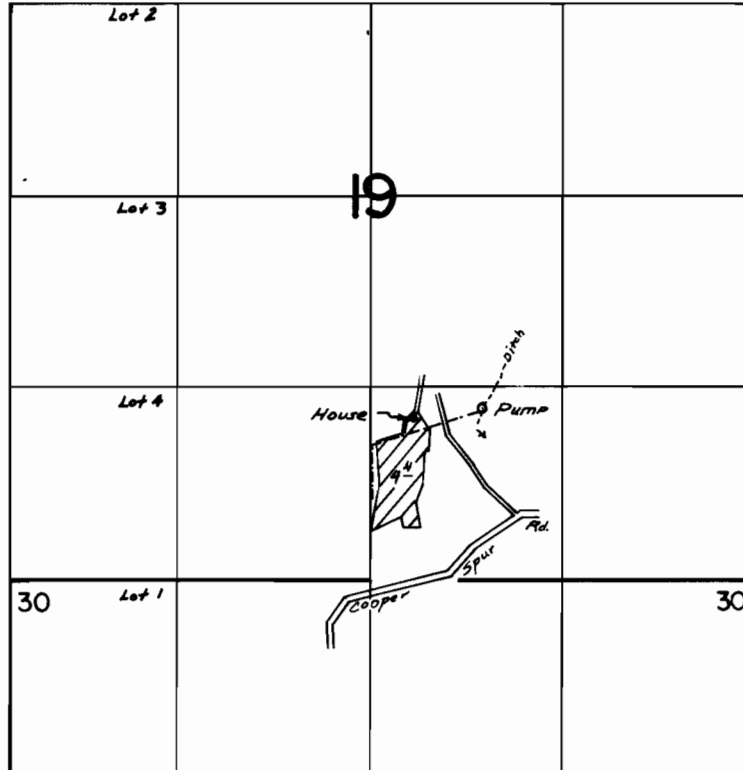


T. 1 S., R. 10 E., W. M.

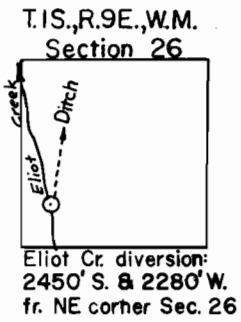

FINAL PROOF SURVEY UNDER

Application No. .48105... Permit No. .36065.....
IN NAME OF

MIDDLE.....FORK.....IRRIGATION.....DIST.

Surveyed .AUG...29. 1978., by ...T...PAUL.....