


T.5S.R.1E.W.M.

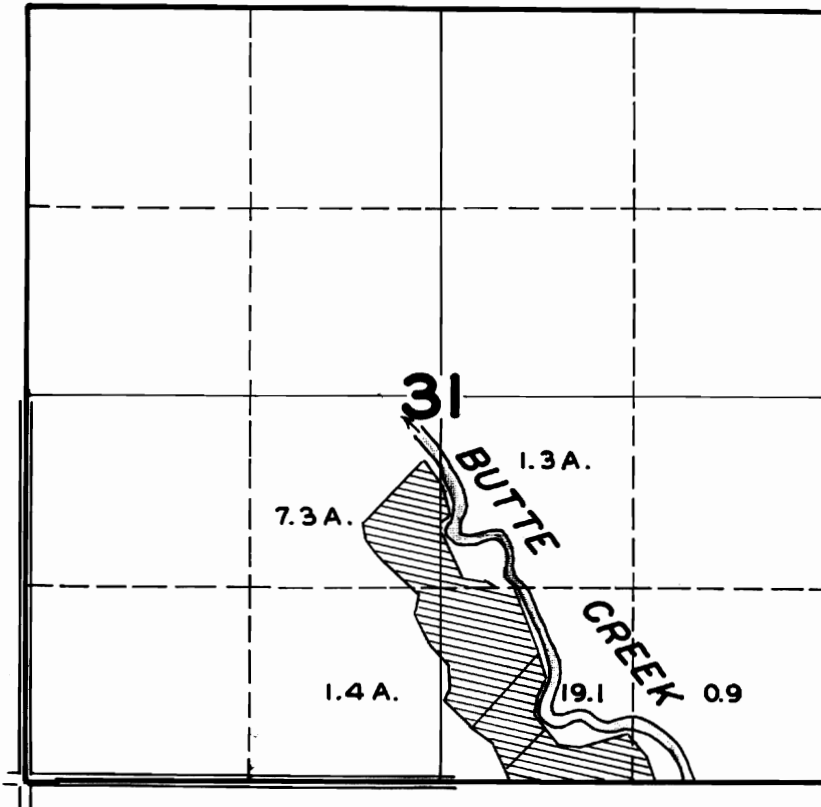

FINAL PROOF SURVEY

UNDER

Application No. 21086 Permit No. 16524

IN NAME OF

HENRY ANNEN

Surveyed APR. 19 1949, by JAS. E. BUNNELL