


G5510 5

CANCELLED
V.S.D.P. 610-629

T-7003 T-6925
72775
74274

T. IS., R. 32E., W.M.

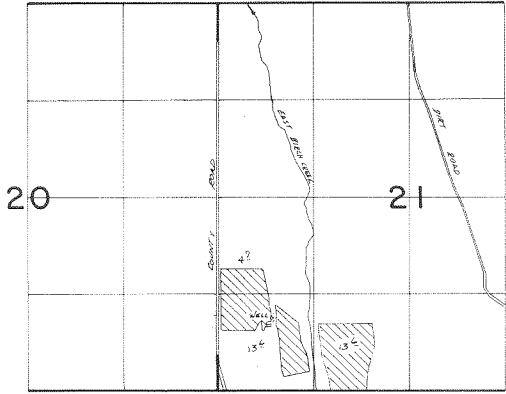

Well Loc. 1000' N & 750' E From SW Cor. Sec 21

FINAL PROOF SURVEY
UNDER

Application No. G:5701. Permit No. G:5510.
IN NAME OF

CHARLES W. & DIXIE CUMISKY.

Surveyed ^{21st} ~~1st~~ ²⁰⁰² ~~1987~~ A.D., by *W. L. Church*