


T.30&31S. R.8E. W.M.

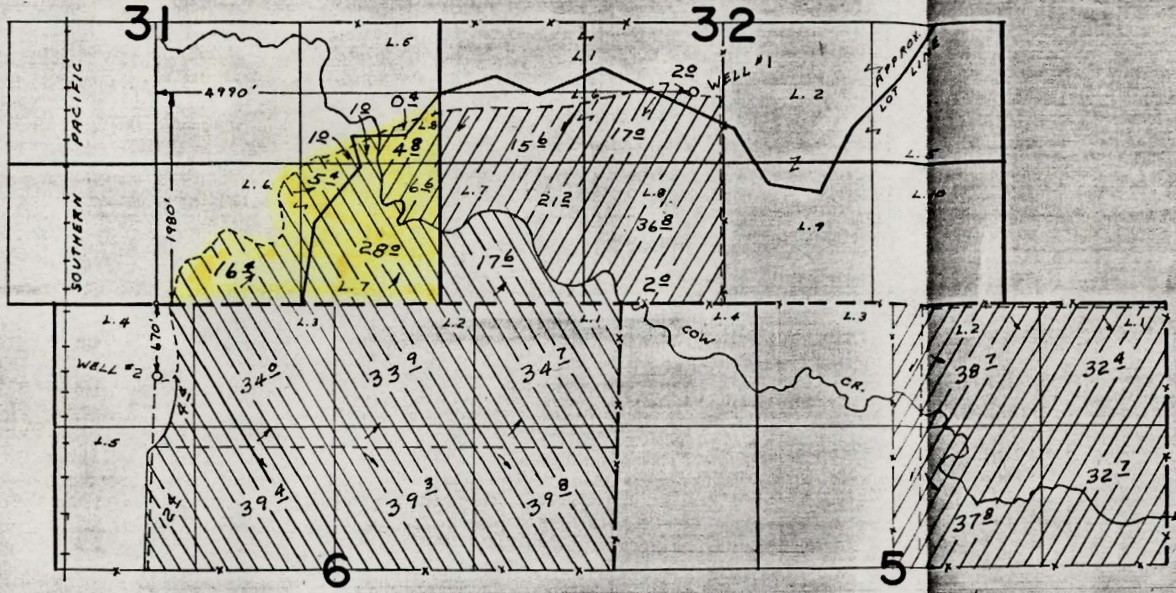

*Williamson River wells*

FINAL PROOF SURVEY  
UNDER

APPLICATION NO. G-3527 PERMIT NO. G-3319  
IN NAME OF

HOWARD N. LIGHTNER

SURVEYED JUN 4, 1975 BY L. H. NUNN

*Yellow area cancelled Sp. Or. Vol. 51, Pg. 389 2-2-97*