


# FINAL PROOF SURVEY UNDER

G-9361  
G-11460  
74279

APPLICATION #G-10282 -- PERMIT #G-9361 8  
APPLICATION #G-12543 -- PERMIT #G-11460  
SITUATED IN THE NW1/4 SW1/4, SW1/4 SW1/4, SE1/4 SW1/4, AND SW1/4 SE1/4 OF  
SECTION 32, T39S, R12EWM, AND THE NW1/4 NE1/4 OF SECTION 5,  
T40S, R12EWM, KLAMATH COUNTY, OREGON  
AUGUST 1992

Lost River Wells

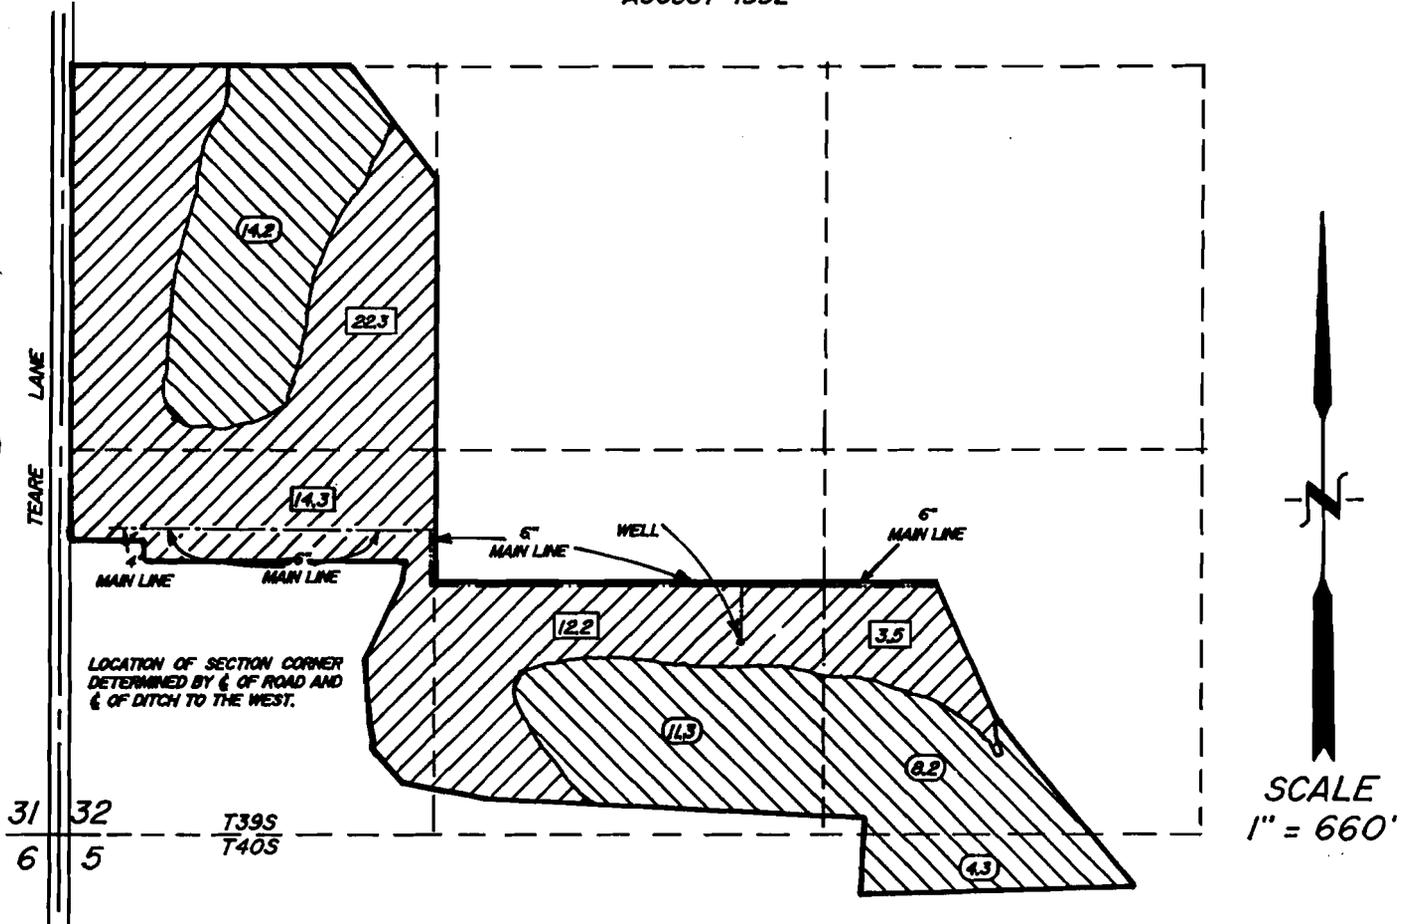


**MAP PREPARED FOR  
-- THE LISTON RANCH --**

LOCATION OF WELL

655 FEET NORTH AND 2360 FEET EAST OF  
THE SOUTHWEST CORNER OF SECTION 32

MAP PREPARED FROM  
BOUNDARIES OF PERMIT DETERMINED  
BY FIELD SURVEY, INTERIOR  
LINES OF PERMITS DETERMINED  
FROM APPLICATION MAPS

- 
INDICATES LANDS UNDER PERMIT #G-9361
38.0 Ac.
- 
INDICATES LANDS UNDER PERMIT #G-11460
52.3 Ac.

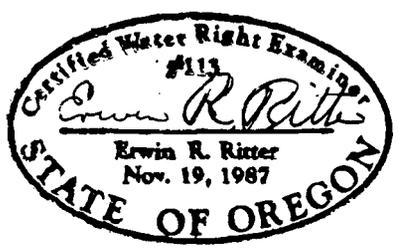

TOTAL ACREAGE  
-- 90.3 AC. --

THE PURPOSE OF THIS MAP IS TO IDENTIFY THE LOCATION OF THE WATER RIGHT. IT IS NOT INTENDED TO PROVIDE INFORMATION RELATIVE TO THE LOCATION OF PROPERTY OWNERSHIP BOUNDARY LINES.

TRU-LINE SURVEYING  
2333 SUMMERS LANE  
KLAMATH FALLS, OR. 97603