


T.25S., R.19E., W.M.

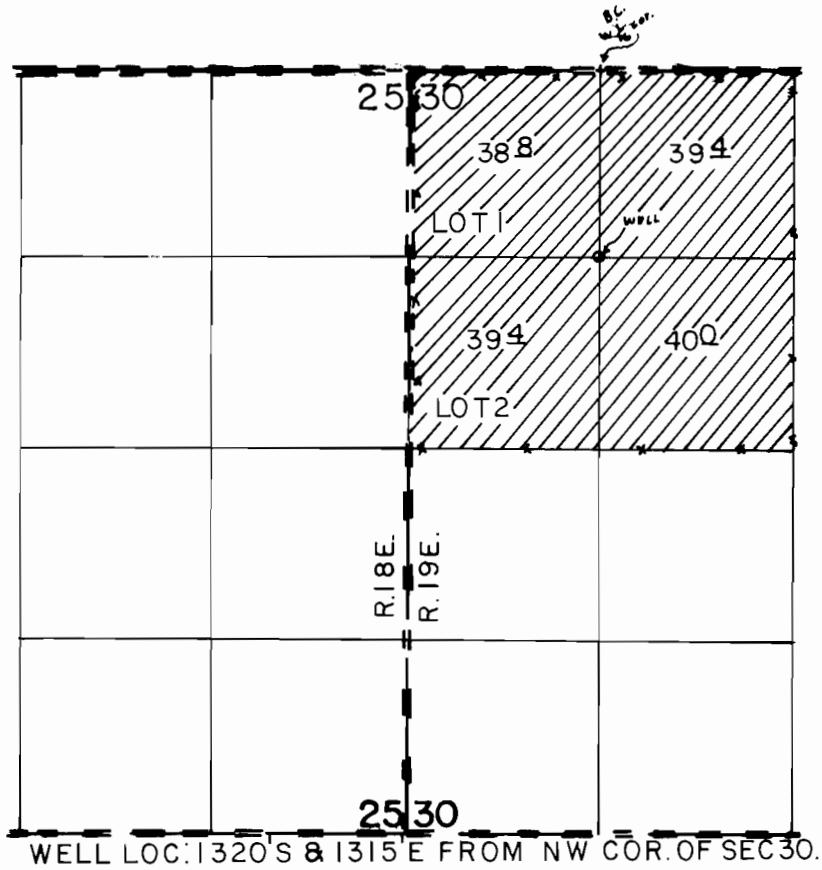

SCALE: 1" = 1320'

**FINAL PROOF SURVEY  
UNDER**

Application No. G-11599 Permit No. G-10806...  
IN NAME OF

JERRY L NEWMAN

Surveyed FEB 19... 19.97., by R. SUTTERFIELD